

STATE OF KANSAS  
STATE CORPORATION COMMISSION

Form CP-4

WELL PLUGGING RECORD

Give All Information Completely  
Make Required Affidavit  
Mail or Deliver Report to:  
Conservation Division  
State Corporation Commission  
212 No. Market  
Wichita, Kansas

Stafford County, Sec. 26 Twp. 21S Rge. 14W (E) (W)

Location as "NE/CNW/SW" or footage from lines NW NW SE

Lease Owner Murfin Drilling Company

Lease Name Pelter Well No. 1

Office Address 617 Union Center, Wichita, Kansas 67202

Character of Well (completed as Oil, Gas or Dry Hole) Oil

Date well completed 12-6 19 68

Application for plugging filed 12-6 19 68

Application for plugging approved 12-6 19 68


Plugging commenced 12-6 19 68

Plugging completed 12-6 19 68

Reason for abandonment of well or producing formation Dry Producer

If a producing well is abandoned, date of last production 9-13 19 68

Was permission obtained from the Conservation Division or its agents before plugging was commenced? Yes

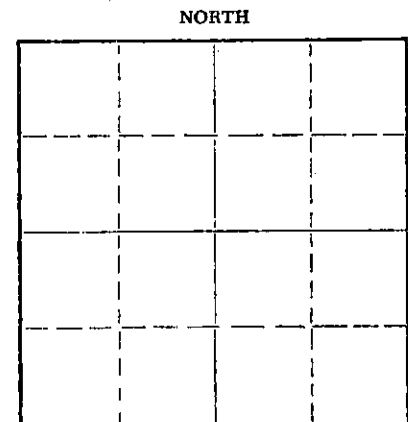

Locate well correctly on above Section Plat

Name of Conservation Agent who supervised plugging of this well R. J. Warren

Producing formation Depth to top Bottom Total Depth of Well 3797 Feet

Show depth and thickness of all water, oil and gas formations.

OIL, GAS OR WATER RECORDS

CASING RECORD

FORMATION	CONTENT	FROM	TO	SIZE	PUT IN	PULLED OUT
				8 5/8"	366'	NONE
				5 1/2"	3677'	NONE

Describe in detail the manner in which the well was plugged, indicating where the mud fluid was placed and the method or methods used in introducing it into the hole. If cement or other plugs were used, state the character of same and depth placed, from feet to feet for each plug set.

- 3530 - 3410 15 sxs. Cement
- 3410 - 1010 15 sxs. Gel
- 1010 - Surf. 85 sxs. Cement

RECEIVED  
STATE CORPORATION COMMISSION  
JAN 24 1969  
CONSERVATION DIVISION  
Wichita, Kansas

(If additional description is necessary, use BACK of this sheet)

Name of Plugging Contractor Murfin Drilling Company

Address 617 Union Center, Wichita, Kansas 67202

STATE OF KANSAS, COUNTY OF SEDGWICK, ss. W. R. Murfin

(employee of owner) or (owner or operator) of the above-described well, being duly sworn on oath, says: That I have knowledge of the facts, statements, and matters herein contained and the log of the above-described well as filed and that the same are true and correct. So help me God.


(Signature) *W. R. Murfin*

(Address)

Subscribed and sworn to before me this 23rd day of January, 1969

SANDRA S. HOLZMAN, Notary Public  
My commission expires March 4, 1972

*Sandra S. Holzman*  
Notary Public.

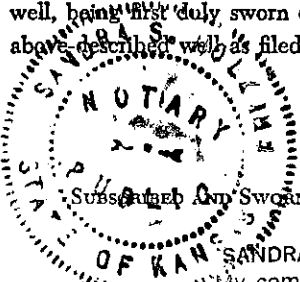

15.185.00613.0000

# WELL LOG

COMPANY Murfin Drilling Co., etal

SEC. 26 T. 21 R. 14W

FARM Pelter NO. 1

LOC. NW NW SE

RIG. NO.

TOTAL DEPTH 3797

COUNTRY Stafford  
KANSAS


COMM. 10-16-50

COMP. 10-29-50

SHOT OR TREATED

CONTRACTOR Murfin Drilling Co.

ISSUED

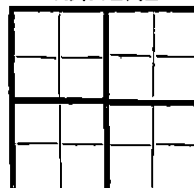

RECEIVED  
STATE CORPORATION COMMISSION  
DEC 3 1968  
CONSERVATION DIVISION  
Wichita, Kansas

1928 Ground  
1933 Rotary Bushing

CASINO

20 10  
15 8 5/8 366 - cem. 250 sacks  
12 6  
13 5 1/2 3677 - cem. 75 sacks

PRODUCTION 230 BOPD

FIGURES INDICATE BOTTOM OF FORMATIONS

80	sand	
130	shale-shells	Tops - Rotary Bushing
280	sand	
366	sand-red bed	Heebner 3282 (-1349)
840	red bed, shale, shells	Br. Lime 3401 (-1468)
870	anhydrite	Lans.-K.C. 3412 (-1479)
885	shale	Viola Chert 3684 (-1751)
1300	shale-shells	Simpson Shale 3733 (-1800)
1570	salt, shale	Arbuckle 3777 (-1844)
1840	lime	
1930	lime, sand	
2030	lime-shale	Perforated - Ground Measure
2135	lime	12 holes 3569-73
2290	lime-shale	10 holes 3591-95
2385	lime	Acidized - 1000 gallons
3150	lime-shale	
3235	lime	
3290	lime-shale	
3390	shale	
3700	lime	
3735	lime-shale	
3780	shale	
3797	lime	
	T.D.	

RECEIVED  
STATE CORPORATION COMMISSION  
NOV 27 1968  
CONSERVATION DIVISION  
Wichita, Kansas

State of KANSAS  
County of SEDGWICK } ss:

I, James R. Daniels of the Murfin Drilling Company Company

upon oath state that the above and foregoing is a true and correct copy of the log of the Pelter No. 1 well.



James R. Daniels  
James R. Daniels  
Subscribed and sworn to before me this 21st day of November 19 68  
Adela Mizener  
NOTARY PUBLIC  
My commission expires November 5, 1970