


15.185.21220.0000

STATE OF KANSAS
STATE CORPORATION COMMISSION

WELL PLUGGING RECORD

Give All Information Completely
Make Required Affidavit
Mail or Deliver Report to
Conservation Division
State Corporation Comm.
245 North Water
Wichita, KS 67202

Stafford County, Sec. 6 Twp. 21 Rge. 14 E/W
Location as "NE/CNW $\frac{1}{4}$ SW $\frac{1}{4}$ " or footage from lines
1980' FEL & 1220' FNL
Lease Owner Mustang Drilling & Exploration, Inc.
Lease Name T. F. Dwyer Well No. 1
Office Address Box 1425, Great Bend, Kansas 67530
Character of Well (Completed as Oil, Gas or Dry Hole)

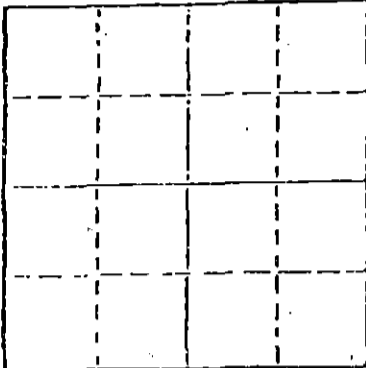

Locate well correctly on above
Section Plat

Dry Hole
Date Well completed Jan. 29 1981
Application for plugging filed Jan. 29 1981
Application for plugging approved Jan. 29 1981
Plugging commenced Jan. 29 1981
Plugging completed Jan. 29 1981
Reason for abandonment of well or producing formation

Dry Hole
If a producing well is abandoned, date of last production 19.

Was permission obtained from the Conservation Division or its agents before plugging was commenced? yes

Name of Conservation Agent who supervised plugging of this well Maurice Leslie
Producing formation _____ Depth to top _____ Bottom _____ Total Depth of Well 3750'
Show depth and thickness of all water, oil and gas formations.

OIL, GAS OR WATER RECORDS

CASING RECORD

FORMATION	CONTENT	FROM	TO	SIZE	PUT IN	PULLED OUT
				8 5/8"	912'	none

Describe in detail the manner in which the well was plugged, indicating where the mud fluid was placed and the method or methods used in introducing it into the hold. If cement or other plugs were used, state the character of same and depth placed, from _____ feet to _____ feet for each plug set.

- First plug @ 910' w/50 sacks Common
- Second plug @ 400' w/40 sacks Common
- Solid bridge plug @ 40' w/10 sacks Common
- 5 sacks Common in rathole
- 2 sacks in water well

2-5-81
FEB - 5 1981

(If additional description is necessary, use BACK of this sheet)

Name of Plugging Contractor Mustang Drilling & Exploration, Inc. Wichita, Kansas

STATE OF KANSAS COUNTY OF BARTON, ss.
Milford Martin (employee of owner) or (owner or operator)
of the above-described well, being first duly sworn on oath, says: That I have knowledge of the facts, statements, and matters herein contained and the log of the above-described well as filed and that the same are true and correct. So help me God.

(Signature) Milford Martin
Box 1425, Great Bend, Kansas 67530
(Address)

SUBSCRIBED AND SWORN TO before me this 3rd day of February, 1981

My commission expires _____

Beverly Shewbart
Notary Public.

DRILLERS' WELL LOG

DATE COMMENCED: January 23, 1981
DATE COMPLETED: January 29, 1981

Mustagg Drilling & Exploration, Inc.
T. F. DWYER # 1
1980 FEL & 1220 FNL of
Sec 6-T21-R14W
Stafford County, Kansas

Elevation: 1926 K.B.

0 - 650'	Surface Soil, Shale
650 - 883'	Red Bed
883 - 911'	Anhydrite
911 - 1730'	Shale
1730 - 3250'	Shale, Lime
3250 - 3255'	Shale
3255 - 3266'	Shale, Lime
3266 - 3284'	Lime
3284 - 3356'	Shale
3356 - 3366'	Lime, Shale
3366 - 3598'	Lime
3598 - 3704'	Lime, Shale
3704 - 3750'	Dolomite
3750'	RTD

API # 15-185-21,220

FORMATION TOPS (Log)

Anhydrite	886	+1040
Heebner	3250	-1324
Toronto	3266	-1340
Douglas	3284	-1358
Brown Lime	3356	-1430
Lansing	3366	-1440
Base K.C.	3598	-1672
Arbuckle	3704	-1778
RTD	3750	-1824
LTD	3749	-1823

Surface Pipe:

Set used 8 5/8", 24# pipe
@ 912' w/225 sacks 50/50 Pozmix,
2% Gel, 3% cc & 175 sacks Common
2% Gel, 3% cc.

A F F I D A V I T

STATE OF KANSAS)
COUNTY OF BARTON) ss.

FEB - 5 1981
COUNTY CLERK
BARTON COUNTY, KANSAS

I, Milford Martin, of Mustang Drilling & Exploration, Inc. do state
that the above is true and correct to the best of my knowledge.

Milford Martin

Milford Martin

Subscribed and sworn to before me this 3rd day of February, 1981.

Beverly Shewbart

Notary Public

My Commission Expires:

