


WELL PLUGGING RECORD

Give All Information Completely
Make Required Affidavit
Mail or Deliver Report to:
Conservation Division
State Corporation Commission
800 Bitting Building
Wichita, Kansas

Stafford County. Sec. 6 Twp 21 Rge 14 ~~W~~ (W)
Location as "NE/CNW $\frac{1}{4}$ SW $\frac{1}{4}$ " or footage from lines S.W. SW NW
Lease Owner The Palmer Oil Corporation
Lease Name Heneisen Well No. 1
Office Address 415 Union National Bank Building, Wichita, Kansas
Character of Well (completed as Oil, Gas or Dry Hole) Dry Hole
Date well completed March 16, 1953
Application for plugging filed March 16, 1953
Application for plugging approved March 16, 1953
Plugging commenced March 16, 1953
Plugging completed March 16, 1953
Reason for abandonment of well or producing formation Dry Hole

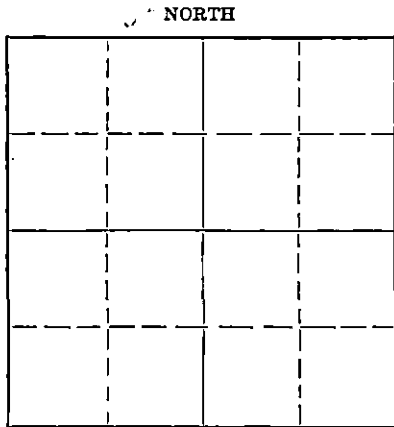

Locate well correctly on above Section Plat

If a producing well is abandoned, date of last production 19
Was permission obtained from the Conservation Division or its agents before plugging was commenced? Yes

Name of Conservation Agent who supervised plugging of this well M. A. Rives
Producing formation Depth to top Bottom Total Depth of Well 3830 Feet
Show depth and thickness of all water, oil and gas formations.

OIL, GAS OR WATER RECORDS

CASING RECORD

Formation	Content	From	To	Size	Put In	Pulled Out
				8 5/8	884	None

Describe in detail the manner in which the well was plugged, indicating where the mud fluid was placed and the method or methods used in introducing it into the hole. If cement or other plugs were used, state the character of same and depth placed, from feet to feet for each plug set.

Filled with heavy mud 3830' to 300'
Plug at 300' with 20 sacks cement
Plug at 35' with 10 sacks cement

RECEIVED
STATE CORPORATION COMMISSION
MAR 21 1953
CONSERVATION DIVISION
Wichita, Kansas

(If additional description is necessary, use BACK of this sheet)
Name of Plugging Contractor The Palmer Oil Corporation
Address 415 Union National Bank Building, Wichita 2, Kansas

STATE OF KANSAS, COUNTY OF SEDGWICK, ss.
Edgar E. Smith (employee of owner) ~~or contractor or operator~~ of the above-described well,

being first duly sworn on oath, says: That I have knowledge of the facts, statements, and matters herein contained and the log of the above-described well as filed and that the same are true and correct. So help me God.

(Signature) *Edgar E. Smith*
Union National Bank Bldg., Wichita, Kansas
(Address)

SUBSCRIBED AND SWORN to before me this 20th day of March, 1953
Kris Meyer
Notary Public.

My commission expires 7/23/55 23-8390-s 6-51-20M

PLUGGING
FILE SEC 6 T 21 R 14 W
BOOK PAGE 85 LINE 16

WELL LOG - HEUEISEN #1

WELL OWNER: The Palmer Oil Corporation

Location: SW SW NW

CONTRACTOR: The Palmer Oil Corporation

Section 6-21S-14W

Stafford County, Kansas

Elevation: 1931 R. B.

Commenced: 3/2/53

Completed: 3/16/53

RESULTS: Dry Hole

Casing Record

Figures Indicate Bottom of Formation

8 5/8" - 884' cemented 350 sacks

Sand & shale	235
Shale	305
Sand	418
Shale	575
Shale & shells	855
Shale	879
Anhydrite	915
Shale & red bed	1350
Sand & salt	1500
Shale & lime	2030
Lime	2105
Shale & lime	3115
Lime	3270
Shale with lime	3353
Lime	3644
Lime & Chert	3754
Arbuckle	3830 R. T. D.

Formation Tops (R. B.)

Heebner	3248
Brown Lime	3352
Lansing	3362
Cherty Congl.	3644
Arbuckle	3754
Total Depth	3830

RECEIVED
STATE CORPORATION COMMISSION

MAR 21 1953

CONV. DIVISION

This is to certify that the above is a true and correct log, according to the daily drilling reports.

THE PALMER OIL CORPORATION

By *Edgar E. Smith*

STATE OF KANSAS)
) ss:
SEDGWICK COUNTY)

Subscribed and sworn to before me, a Notary Public in and for said County and State, this 20th day of March, 1953.

Iris Meyer
Notary Public

My Commission Expires: 7/23/55.

PLUGGING
FILE SEC 6 T 21 R 14W
PAGE 85 LINE 6