

STATE OF KANSAS
STATE CORPORATION COMMISSION


WELL PLUGGING RECORD

Give All Information Completely
Make Required Affidavit
Mail or Deliver Report to:
Conservation Division
State Corporation Commission
800 Bittling Building
Wichita, Kansas

Stafford County, Sec. 32 Twp 21S Rge 13W (E) (W)

Location as "NE/CNW $\frac{1}{4}$ SW $\frac{1}{4}$ " or footage from lines SW NE SE
Lease Owner Francis M. Raymond
Lease Name Chapman Well No. 3
Office Address 202 Bissantz Bldg., Wichita, Kansas
Character of Well (completed as Oil, Gas or Dry Hole) Abandoned Oil Well
Date well completed March 22, 1950 19
Application for plugging filed March 14, 1951 19
Application for plugging approved March 15, 1951 19
Plugging commenced March 24, 1951 19
Plugging completed April 2, 1951 19
Reason for abandonment of well or producing formation oil depleted

NORTH

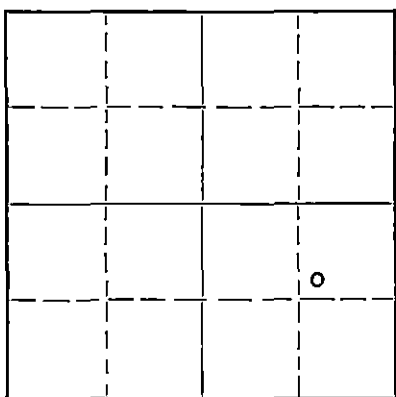

Locate well correctly on above
Section Flat

If a producing well is abandoned, date of last production 19
Was permission obtained from the Conservation Division or its agents before plugging was commenced? Yes

Name of Conservation Agent who supervised plugging of this well C. D. Stough
Producing formation Depth to top Bottom Total Depth of Well 3768 Feet
Show depth and thickness of all water, oil and gas formations.

OIL, GAS OR WATER RECORDS

CASING RECORD

Formation	Content	From	To	Size	Put In	Pulled Out
				10 3/4"	321'	
				7"	3768'	

Describe in detail the manner in which the well was plugged, indicating where the mud fluid was placed and the method or methods used in introducing it into the hole. If cement or other plugs were used, state the character of same and depth placed, from feet to feet for each plug set.

Filled hole with sand from 3768 feet to 3510 feet before pipe was pulled. Dumped 6 sacks of cement at 3510 feet. Shot off and pulled the 7 inch casing. Mudded hole to 200 feet. Set Rock bridge (10 foot) and 20 sacks of cement at 200 feet. Mudded hole to 30 feet. Set plug and 10 sacks of cement at the surface.

Arnett Casing Pulling Company; Plugging Contractor

(If additional description is necessary, use BACK of this sheet)

Correspondence regarding this well should be addressed to Francis M. Raymond
Address 202 Bissantz Bldg., Wichita, Kansas

STATE OF KANSAS, COUNTY OF SEDGWICK, ss.

(employee of owner) or (owner or operator) of the above-described well, being first duly sworn on oath, says: That I have knowledge of the facts, statements, and matters herein contained and the log of the above-described well as filed and that the same are true and correct. So help me God.

(Signature) Mike Raymond

202 Bissantz Bldg., Wichita, Kansas
(Address)

SUBSCRIBED AND SWORN to before me this 13th day of July 19 51

My Commission Expires Jan. 31, 1953

My commission expires

Seward S. Greibe
Notary Public.

PLUGGING
FILE SEC 32 T 21 R 13W
BOOK PAGE 67 LINE 13

RECEIVED
STATE CORPORATION COMMISSION
JUL 13 1951
CONSERVATION DIVISION
Wichita, Kansas