


STATE OF KANSAS
STATE CORPORATION COMMISSION

WELL PLUGGING RECORD

Give All Information Completely
Make Required Affidavit
Mail or Deliver Report to:
Conservation Division
State Corporation Commission
800 Bittling Building
Wichita, Kansas

NORTH

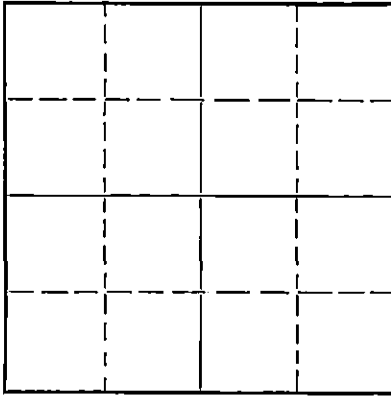

Locate well correctly on above
Section Plat

Stafford County. Sec. 11 Twp. 21 Rge. 14 (E) (W)
Location as "NE/CNW 1/4 SW 1/4" or footage from lines SE SE SE
Lease Owner Petroleum, Inc.
Lease Name Hullett Well No. 1
Office Address 100 Derby Building, Wichita 2, Kansas
Character of Well (completed as Oil, Gas or Dry Hole) Dry Hole
Date well completed January 27, 1951
Application for plugging filed January 27, 1951
Application for plugging approved January 27, 1951
Plugging commenced January 27, 1951
Plugging completed January 27, 1951
Reason for abandonment of well or producing formation Dry Hole

If a producing well is abandoned, date of last production 19...
Was permission obtained from the Conservation Division or its agents before plugging was commenced? Yes

Name of Conservation Agent who supervised plugging of this well Mr. Charles Stough
Producing formation Depth to top Bottom Total Depth of Well 3710 Feet
Show depth and thickness of all water, oil and gas formations.

OIL, GAS OR WATER RECORDS

CASING RECORD

Formation	Content	From	To	Size	Put In	Pulled Out
				8 5/8	250'	None

Describe in detail the manner in which the well was plugged, indicating where the mud fluid was placed and the method or methods used in introducing it into the hole. If cement or other plugs were used, state the character of same and depth placed, from feet to feet for each plug set.

Wooden plug set at 240'. Cemented and displaced through drill pipe 15 sax. Filled hole with heavy mud to 30'. Placed wooden plug at 30'. Filled hole to surface with cement.

RECEIVED
STATE CORPORATION COMMISSION
FEB - 1 1951
CONSERVATION DIVISION
WICHITA, KANSAS

(If additional description is necessary, use BACK of this sheet)

Correspondence regarding this well should be addressed to Petroleum, Inc.
Address 100 Derby Bldg., Wichita 2, Kansas

STATE OF KANSAS, COUNTY OF SEDGWICK, ss.
Eric H. Jager

(employee of owner) of the above-described well, being first duly sworn on oath, says: That I have knowledge of the facts, statements, and matters herein contained and the log of the above-described well as filed and that the same are true and correct. So help me God.

(Signature) Eric H. Jager
100 Derby Building, Wichita, Kansas
(Address)

SUBSCRIBED AND SWORN to before me this 30th day of January, 1951

My commission expires October 13, 1954

Charlotte Heidman
Notary Public.

PLUGGING
FILE SEC 11 T 21 R 14
BOOK PAGE 59 LINE 1

WELL LOG HULLETT #1

Petróleum, Inc., Lease Owner

Section 11, Twp. 21S, Rge. 14W

Garvey Oil, Contractor

Location: SE SE SE

Rotary Total Depth: 3710'

County: Stafford, Kansas

Commenced: January 18, 1951

Production: D & A

Completed: January 27, 1951

Elevation: 1926 R.B.

Casing: 246' of 8 5/8"

Figures below indicate bottom of formation:

35	Surface Soil & Clay	3662	Chert
210	Sand & Clay	3695	Shale
246	Shale	3710	Shale & Lime
350	Shale & Shells		
825	Red Bed	3710'	R.T.D.
850	Anhydrite		
882	Shale & Shells		
1650	Lime & Shale		
2130	Lime	3342	Heebner
2245	Lime & Shale	3262	Toronto
2990	Lime	3282	Base Oread
3100	Lime & Shale	3362	Brown Lime
3157	Lime	3372	Lansing
3297	Lime & Shale	3592	Base Kansas City
3412	Lime	3616	Conglomerate
3606	Lime & Shale	3661	Simpson
3616	Shale	3706	Arbuckle
3628	Cong.		
3649	Viola		

Tops:

I hereby certify that this is a true and correct log of the above mentioned well.

PETROLEUM, INC.

Eric H. Jager
Eric H. Jager

STATE OF KANSAS :
 : SS.
COUNTY OF SEDGWICK:

Subscribed to and sworn to before me, a Notary Public in said County and State this 30th day of January, 1951.

Charlotte
Notary Public
RECEIVED
STATE COMMISSION
FEB - 1 1951

My commission expires: October 13, 1954

PLUGGING
FILE SEC 11 T 21 R 140
BOOK PAGE 59 LINE 1
CONSERVATION DIVISION
Wichita, Kansas