


Give All Information Completely  
Make Required Affidavit  
Mail or Deliver Report to:  
Conservation Division  
State Corporation Commission  
211 No. Broadway  
Wichita, Kansas

WELL PLUGGING RECORD

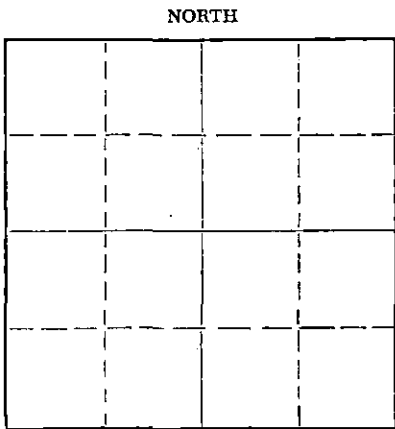

Locate well correctly on above  
Section Plat

Stafford County. Sec. 11 Twp. 21S Rge. 14W (E) (W)  
Location as "NE/CNW&SW¼" or footage from lines NE NE NE  
Lease Owner Alpine Oil & Royalty Co., Inc.  
Lease Name Frank Schartz Well No. 1  
Office Address 800 Bitting Building, Wichita, Kansas  
Character of Well (completed as Oil, Gas or Dry Hole) dry hole  
Date well completed December 8, 1958 19  
Application for plugging filed December 8, 1958 19  
Application for plugging approved December 8, 1958 19  
Plugging commenced December 8, 1958 19  
Plugging completed December 8, 1958 19  
Reason for abandonment of well or producing formation non-productive  
in commercial quantities  
If a producing well is abandoned, date of last production \_\_\_\_\_ 19  
Was permission obtained from the Conservation Division or its agents before plugging was commenced? Yes

Name of Conservation Agent who supervised plugging of this well Frank Broadfoot  
Producing formation \_\_\_\_\_ Depth to top \_\_\_\_\_ Bottom \_\_\_\_\_ Total Depth of Well 3755 Feet  
Show depth and thickness of all water, oil and gas formations.

OIL, GAS OR WATER RECORDS

CASING RECORD

FORMATION	CONTENT	FROM	TO	SIZE	PUT IN	PULLED OUT
				8 5/8"	291'	cemented

Describe in detail the manner in which the well was plugged, indicating where the mud fluid was placed and the method or methods used in introducing it into the hole. If cement or other plugs were used, state the character of same and depth placed, from \_\_\_\_\_ feet to \_\_\_\_\_ feet for each plug set.

Heavy mud from total depth - 3755 feet - to surface  
a collar was welded on Surface - top plug placed  
in pipe and Halliburton pumped in 80 sacks cement  
and shut it in.

(If additional description is necessary, use BACK of this sheet)

Name of Plugging Contractor Quaker Drilling Co., Inc.  
Address 800 Bitting Building, Wichita, Kansas

STATE OF Kansas, COUNTY OF Sedgwick, ss.  
Thomas M. McCaul (employee of owner) or (owner or operator) of the above-described well, being first duly sworn on oath, says: That I have knowledge of the facts, statements, and matters herein contained and the log of the above-described well as filed and that the same are true and correct. So help me God.

(Signature) Thomas M. McCaul  
800 Bitting Building, Wichita, Kansas  
(Address)

SUBSCRIBED AND SWORN TO before me this 10th day of December, 19 58

My commission expires August 10, 1961

Virginia M. Russell  
Notary Public.



DEC 13 1958

CONSERVATION DIVISION  
Wichita, Kansas

**PLUGGING**  
FILE SEC. 11 T. 21 R. 14W  
BOOK PAGE 2 LINE 31

WELL LOG

ALPINE OIL &amp; ROYALTY CO., INC.

Commenced: November 29, 1958

Contractor: Quaker Drilling Co., Inc.

Completed: December 8, 1958

Frank Schartz No. 1  
NE NE NE Sec. 11-21S-14W  
Stafford County, Kansas

Elevation: 1923 KB

Production: D. &amp; A.

## Casing Record:

Set 8 5/8" at 291 feet with 300 sacks pozmix

(Figures Indicate the Bottom of the Formations)

<u>FORMATION</u>	<u>DEPTH</u>	<u>FORMATION TOPS</u>	
Surface Soil	20	Heebner	3239 -1316
Sand	230	Brown Lime	3358 -1435
Shale	291	Lansing	3368 -1445
Shale and Shells	300	Base of Kansas City	3598 -1675
Sand	495	Viola	3617 -1694
Red Bed, Shale and Sand Streaks	810	Rotary Total Depth	3755 -1832
Anhydrite	840		
Shale and Shells	1710		
Lime and Shale	3700		
Lime	3755		

We hereby certify the foregoing to be a true and correct copy of the Driller's Log of the well drilled in the NE NE NE of Section 11, Township 21 South, Range 14 West Stafford County, Kansas.

QUAKER DRILLING CO., INC.

By: Thomas M. McCaul

Thomas M. McCaul

SUBSCRIBED AND SWORN TO before me, a Notary Public, this 10th day of December, 1958.

Virginia Mundell  
Virginia Mundell, Notary Public

MY COMMISSION EXPIRES:  
August 10, 1961

RECEIVED  
STATE CORPORATION COMM'

DEC 13 1958

CONSERVATION DIVISION  
Wichita, Kansas

PLUGGING			
FILE	SEC. 11	T. 21	R. 14W
BOOK	PAGE 2	LINE	31