

WELL PLUGGING RECORD

Give All Information Completely  
Make Required Affidavit  
Mail or Deliver Report to:  
Conservation Division  
State Corporation Commission  
211 No. Broadway  
Wichita, Kansas

Stafford

County. Sec. 20 Twp. 21S Rg. 14 ~~XX~~XX (W)

Location as "NE/CNW/SW" or footage from lines SW NW NW

Lease Owner D.R. Lauck Oil Company, Inc.

Lease Name Russell Well No. 1

Office Address 301 South Broadway Wichita 2 Kans

Character of Well (completed as Oil, Gas or Dry Hole) dry hole

Date well completed April 12 1958

Application for plugging filed " " 1958

Application for plugging approved " " 1958


Plugging commenced " " 1958

Plugging completed " " 1958

Reason for abandonment of well or producing formation dry hole

If a producing well is abandoned, date of last production 19

Was permission obtained from the Conservation Division or its agents before plugging was commenced? yes

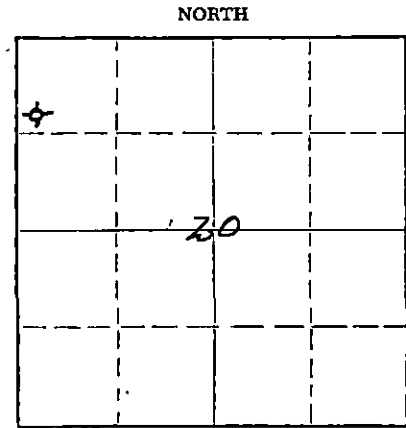

Locate well correctly on above Section Plat

Name of Conservation Agent who supervised plugging of this well Frank Broadfoot

Producing formation \_\_\_\_\_ Depth to top \_\_\_\_\_ Bottom \_\_\_\_\_ Total Depth of Well 3780 Feet

Show depth and thickness of all water, oil and gas formations.

OIL, GAS OR WATER RECORDS				CASING RECORD		
FORMATION	CONTENT	FROM	TO	SIZE	PUT IN	PULLED OUT
		0	664	8 5/8"	664	none

Describe in detail the manner in which the well was plugged, indicating where the mud fluid was placed and the method or methods used in introducing it into the hole. If cement or other plugs were used, state the character of same and depth placed, from \_\_\_\_\_ feet to \_\_\_\_\_ feet for each plug set.

hole filled with mud 3780 - 300'  
 plug 300 - 296  
 cement 296 - 35  
 plug 35 - 31  
 cement 31 - 6 bottom of cellar


RECEIVED  
STATE CORPORATION COMMISSION  
APR 16 1958  
CONSERVATION DIVISION  
Wichita, Kansas

Name of Plugging Contractor (If additional description is necessary, use BACK of this sheet) Globe Cementing Company  
 Address Great Bend Kansas

STATE OF Kansas COUNTY OF Sedgwick ss.  
 John H. Knightley (employee of owner) or (owner or operator) of the above-described well, being first duly sworn on oath, says: That I have knowledge of the facts, statements, and matters herein contained and the log of the above-described well as filed and that the same are true and correct. So help me God.

(Signature) John H. Knightley  
 Wichita Kansas  
 (Address)

SUBSCRIBED AND SWORN to before me this 17 day of April 19 58  
 Elizabeth Gay  
 My commission expires Sept. 14, 1959  
 Notary Public.

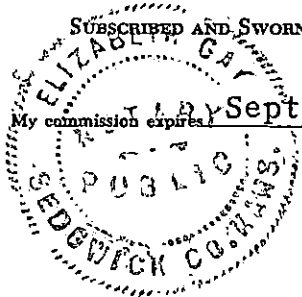

PLUGGING  
 FILE NO. 20T. 21 R. 14W  
 BOOK PAGE 93 LINE 24

D. R. Lauck Oil Company, Inc.  
and Sunray Mid-Continent Oil Company

Russell No.1

SW NW NW Sec.20-21S-14W  
Stafford County Kansas

Commenced: April 2 1958  
Completed: April 12 1958

Casing Record: 664 ft 8 5/8" cem.with 425 sax  
Calcium Chloride 5 "

Elevation: GR 1941; DF 1943; KB 1945

Drillers Log

Surface Clay & Sand	40
sand	195
shale	310
sand	400
red bed & shale	865
Anhydrite	880
red bed & shale	1255
shale & shells	1600
lime & shale	2040
Lime	2120
shale & lime	2530
shale & shells	2675
shale & lime	2795
lime & shale	2920
lime (Broken)	3050
lime	3260
lime & shale	3415
Lime (Lansing)	3720
Simpson	3722
Lime & shale	3746
Lime	3780 RTD

Tops

	Sample	Welex
Anhydrite(drillers)	865+1080	
Heebner	3274-1329	3273-1328
Toronto	3290-1345	3290-1345
Douglas	3308-1363	3306-1361
Brown Lime	3381-1436	3380-1435
Lsg Kansas City	3392-1447	3391-1446
Base Kansas City	3622-1677	3622-1677
Viola	3644-1699	3644-1699
Simpson Shale	3690-1745	3693-1748
Arbuckle	3746-1801	3746-1801
Rotary Total Depth	3780-1835	3779-1834

DST #1 (W) 3540-3555; open 1 hr.  
weak blow 1 hour; recov. 90';  
muddy salt water. FP 0#  
BHP 1210# in 20 min.

D & A

RECEIVED  
STATE CORPORATION COMMISSION

APR 18 1958

CONSERVATION DIVISION  
Wichita, Kansas

PLUGGING  
FILE SEC 20 T. 21 R. 14W  
BOOK PAGE 93 LINE 24