


WELL PLUGGING RECORD

Give All Information Completely  
Make Required Affidavit  
Mail or Deliver Report to:  
Conservation Division  
State Corporation Commission  
211 So. Broadway  
Wichita, Kansas

Stafford County, Sec. 20 Twp. 21 Rge. 14 (SE) (W)

Location as "NE/CNW%SW%" or footage from lines E $\frac{1}{2}$  E $\frac{1}{2}$  SE $\frac{1}{4}$   
Lease Owner D.R. Lauck Oil Co., Inc., Sunray Mid-Continent Oil  
Lease Name Fullerton Well No. 2  
Office Address 301 So. Broadway Wichita Kans  
Character of Well (completed as Oil, Gas or Dry Hole) dry hole  
Date well completed January 14 19 57  
Application for plugging filed January 14 19 57  
Application for plugging approved January 14 19 57  
Plugging commenced January 14 19 57  
Plugging completed January 15 19 57  
Reason for abandonment of well or producing formation dry hole

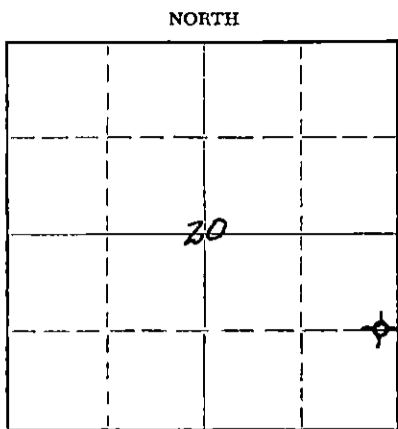

Locate well correctly on above Section Flat

If a producing well is abandoned, date of last production 19  
Was permission obtained from the Conservation Division or its agents before plugging was commenced? yes

Name of Conservation Agent who supervised plugging of this well R. M. Brundage  
Producing formation --- Depth to top --- Bottom --- Total Depth of Well 3821 Feet  
Show depth and thickness of all water, oil and gas formations.

OIL, GAS OR WATER RECORDS

CASING RECORD

FORMATION	CONTENT	FROM	TO	SIZE	PUT IN	PULLED OUT
		0	869	8 5/8"	869'	none

Describe in detail the manner in which the well was plugged, indicating where the mud fluid was placed and the method or methods used in introducing it into the hole. If cement or other plugs were used, state the character of same and depth placed, from   feet to   feet for each plug set.

Hole filled with mud

mud 3821 - 250  
plug 250 - 246  
cement 246 - 206  
mud 206 - 35  
plug 35 - 31  
cement 31 - 6 bottom of cellar

RECEIVED  
STATE CORPORATION COMMISSION

CONSERVATION DIVISION  
Wichita, Kansas

1-19-57

(If additional description is necessary, use BACK of this sheet)  
Name of Plugging Contractor Sun Oil Well Cementing Company  
Address Great Bend Kansas

STATE OF Kansas, COUNTY OF Sedgwick, ss.  
John H. Knightley (employee of owner) or (owner or operator) of the above-described well, being first duly sworn on oath, says: That I have knowledge of the facts, statements, and matters herein contained and the log of the above-described well as filed and that the same are true and correct. So help me God.

(Signature) John H. Knightley  
Wichita Kans (Address)

SUBSCRIBED AND SWORN TO before me this 18 day of January, 19 57

My commission expires Sept. 14, 1959

E. Elizabeth Gay  
Notary Public.

PLUGGING  
FILE SEC 20 T. 21 R. 14 W  
BOOK PAGE 134 LINE 17

D. R. Lauck Oil Company, Inc.  
& Sunray Mid-Continent Oil Company

Fullerton No. 2

E $\frac{1}{2}$  E $\frac{1}{2}$  SE $\frac{1}{4}$  Sec. 20-21S-14W  
Stafford County Kansas

Commenced: January 2, 1957  
Completed: January 15, 1957

Elevation: GR 1943; DF 1945; KB 1947;

Casing Record: 869 ft. 8 5/8" cemented w/200 sacks

Drillers LogTops

sand & clay	200
shale	300
sand	395
shale	400
red bed & shale	650
red bed, shale & shells	810
shale & shells	864
Anhydrite	892
red bed & shale	1090
shale & shells	1730
lime & shale	1985
lime broken	2125
lime & shale	2385
shale & shells	2745
shale & lime	2845
lime	2965
lime & shale	3070
lime	3275
lime & shale	3335
Douglas	3404
shale	3422
lime	3725
chert (Viola)	3742
shale (Simpson)	3764
sand (Simpson)	3767
sand, shale & lime	3796
Arbuckle	3821

Heebner	3304-1357
Douglas	3345-1398
Brown Lime	3421-1474
Lansing	3430-1483
Base Kansas City	3665-1718
Marmaton	3676-1729
Conglomerate	3697-1750
Viola	3706-1759
Simpson shale	3742-1795
Simpson sand	3764-1817
Arbuckle	3796-1849
Rotary Total Depth	3821-1874

DST #1 3562-3576 (M-D) open 30"; weak blow 2 min. and died; recov. 5' drilling mud; all pressures 0.

BBT #2 3707-3725 (M-D) open 30 min. weak blow 7 min; recov. 10' drilling mud; all pressures 0;

DST #3 3764-3767 (M-D) open 1 hr. strong blow 15 min, decreasing to weak blow at end of one hour; recov. 1384 ft salt water; BHP 660# in 30 min. FPO 600#

R T D 3821

RECEIVED  
STATE CORPORATION COMMISSION

JAN 17 1957  
CONSERVATION DIVISION  
Topeka, Kansas

**PLUGGING**

FILE SEC. 20 T. 21 R. 14W  
BOOK PAGE 134 LINE 17