


WELL PLUGGING RECORD

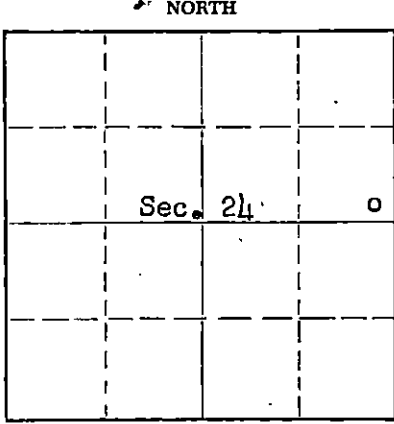

Stafford County. Sec. 24 Twp. 21 Rge. 14 (X) W (W)  
 Location as "NE/CNWxSWx" or footage from lines SE SE NE  
 Lease Owner Petroleum, Inc.  
 Lease Name M. Bordewick Well No. 1  
 Office Address Route 2, Great Bend, Kansas  
 Character of Well (completed as Oil, Gas or Dry Hole) Oil  
 Date well completed November 28, 19 50  
 Application for plugging filed May 13, 19 59  
 Application for plugging approved May 19, 19 59  
 Plugging commenced June 7, 19 59  
 Plugging completed June 10, 19 59  
 Reason for abandonment of well or producing formation Depletion Of  
 Producing Zones  
 If a producing well is abandoned, date of last production May 4, 19 59  
 Was permission obtained from the Conservation Division or its agents before plugging was com-  
 menced? Yes

Name of Conservation Agent who supervised plugging of this well Frank Broadfoot, 222 South Main St., St. John, Ks.  
 Producing formation Kansas City Depth to top 3372' Bottom 3577' Total Depth of Well 3770 Feet  
 Show depth and thickness of all water, oil and gas formations.

OIL, GAS OR WATER RECORDS				CASING RECORD		
FORMATION	CONTENT	FROM	TO	SIZE	PUT IN	PULLED OUT
				8-5/8"	239'	None
				5-9/6"	2123'	2123'
				5-1/2"	1636'	992'
Kansas City	Water & Little Oil	3399'	3407'			
		3501'	3508'			
		3519'	3525'			
		3536'	3540'			
		3553'	3559'			

Describe in detail the manner in which the well was plugged, indicating where the mud fluid was placed and the method or methods used in introducing it into the hole. If cement or other plugs were used, state the character of same and depth placed, from \_\_\_\_\_ feet to \_\_\_\_\_ feet for each plug set.

(Plugged back to 3578')

Filled hole from 3578' to 3375' with crushed rock and placed 5 sacks cement on top of rock. Pumped in 20 sacks commercial gel, followed by plug and 75 sacks cement to base of well cellar.

RECEIVED  
 STATE CORPORATION COMMISSION

JUN 16 1959

CONSERV.  
 WICHITA, KANSAS

6-16-59

(If additional description is necessary, use BACK of this sheet)  
 Name of Plugging Contractor Southwest Casing Pulling Company  
 Address Box 364, Great Bend, Kansas

STATE OF KANSAS, COUNTY OF BARTON, ss.  
 DON SEARLE (employee of owner) or (owner or operator) of the above-described well, being first duly sworn on oath, says: That I have knowledge of the facts, statements, and matters herein contained and the log of the above-described well as filed and that the same are true and correct. So help me God.  
 (Signature) Don Searle  
 Route 2, Great Bend, Kansas (Address)

SUBSCRIBED AND SWORN to before me this 12th day of June, 19 59  
 Arthur J. Miles  
 Notary Public.

My commission expires April 11, 1963.

PLUGGING  
 FILE SEC. 24 T. 21 R. 14W  
 BOOK PAGE 38 LINE 23

COMPANY: PETROLEUM, INC. Rotary Drilling Commenced: 11-7-50  
 Wichita, Kansas Rotary Drilling Completed: 11-20-50

LOCATION: BORDEWICK #1, SE SE NE, Sec. 24-21S-14W  
 Stafford County, Kansas

CONTRACTOR: PICKRELL DRILLING COMPANY, INC.  
 Wichita, Kansas

CASING RECORD: 239' ( 8 Jts.) 8 5/8" New seamless 24# casing set at 239' in a  
 12 1/4" hole, cemented with 155 sacks cement.

3769' ( 118 Jts.) 5 1/2" casing set at 3769' in a 7 7/8" hole,  
 cemented with 100 sacks cement.

L O G

(Figures indicate bottom formation - measurements from top rotary bushing.)

Cellar	5	Circulate for samples at 3409'.
Surface Sand	40	" " " " 3440'.
Sand	140	" " " " 3449'.
Iron	150	" " " " 3470'.
Shale & Shells	240	" " " " 3501'.
Red Bed	1335	" " " " 3541'.
Shale & Shells	1580	" " " " 3570'.
Lime Str. Bro.	1665	" " " " 3696'.
Lime	2145	" " " " 3715'.
Line, hard	2225	" " " " 3720'.
Lime	2240	" " " " 3725'.
Shale & Lime	2290	" " " " 3770'.
Lime & Shale	2445	
Shale & Lime	2840	Slope test at 500' - 0° off.
Lime & Shale	3035	S.L.M. at 500' - O.K.
Lime	3225	Slope test at 1000' - 0° off.
Lime & Heebner Shale	3305	Slope test at 1500' - 0° off.
Lime	3623	Slope test at 2000' - 0° off.
Cherty Lime	3669	Slope test at 2500' - 0° off.
Simpson Shale	3720	S.L.M. at 2500' - O.K.
Arbuckle	3770 Rotary T.D.	Slope test at 3000' - 0° off.
		Slope test at 3500' - 0° off.
		S.L.M. at 3770' - O.K.

The undersigned, C. W. Sebitts, Secretary of PICKRELL DRILLING COMPANY, INC., hereby certifies in behalf of said corporation, that the above log is a true and correct log of the formation encountered in drilling the above well as reflected by the Daily Drilling Reports.

PICKRELL DRILLING COMPANY, INC.  
 By: C. W. Sebitts  
 Secretary

STATE OF KANSAS )  
 COUNTY OF SEDGWICK ) SS

BE IT REMEMBERED that on this 27th day of November, 1950, before me, the undersigned, a Notary Public, duly commissioned, in and for the county and state aforesaid, came C. W. Sebitts, Secretary of Pickrell Drilling Company, Inc., a corporation of the State of Kansas, personally known to me to be such officer, and to be the same person who executed as such officer the foregoing instrument of writing in behalf of said corporation, and he duly acknowledged the execution of the same for himself and for said corporation.

IN WITNESS WHEREOF, I have hereunto set my hand and official seal on the day and year last above written.

Ethel Zimmerman  
 Notary Public

My commission expires January 28, 1953.

RECORDED  
 STATE CORPORATION COMMISSION  
 JUN 16 1959  
 CONSERVATION DIVISION  
 Wichita, Kansas

PLUGGING  
 FILE NO. 24T 21 R 14W  
 BOOK PAGE 28 LINE 23