


STATE OF KANSAS
STATE CORPORATION COMMISSION

WELL PLUGGING RECORD

Give All Information Completely
Make Required Affidavit
Mail or Deliver Report to:
Conservation Division
State Corporation Commission
800 Bittling Building
Wichita, Kansas

Stafford County, Sec. 23 Twp. 21 Rge. 14 (E) (W)
Location as "NE/CNW $\frac{1}{4}$ SW $\frac{1}{4}$ " or footage from lines SW NW SW
Lease Owner J.A. Davis & J.H. Child
Lease Name Van Winkle Well No. 1
Office Address 121 West Second Street, Hutchinson, Kansas
Character of Well (completed as Oil, Gas or Dry Hole) Dry Hole
Date well completed 10-21 1950
Application for plugging filed 10-21 1950
Application for plugging approved 10-21 1950
Plugging commenced 10-21 1950
Plugging completed 10-21 1950
Reason for abandonment of well or producing formation Oil not found in quantity to produce
If a producing well is abandoned, date of last production 19
Was permission obtained from the Conservation Division or its agents before plugging was commenced? YES

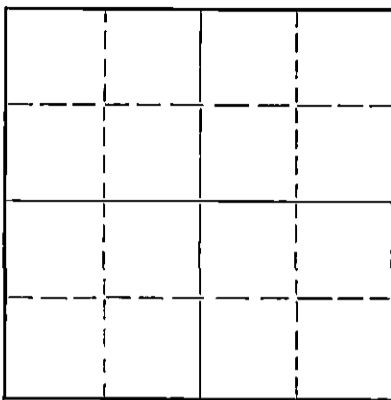

Locate well correctly on above Section Plot

Name of Conservation Agent who supervised plugging of this well G.D. Stough
Producing formation Depth to top Bottom Total Depth of Well 3779 Feet
Show depth and thickness of all water, oil and gas formations.

OIL, GAS OR WATER RECORDS

CASING RECORD

Formation	Content	From	To	Size	Put In	Pulled Out
				8 5/8"	310'	
				5 1/2"	3779'	2999'

Describe in detail the manner in which the well was plugged, indicating where the mud fluid was placed and the method or methods used in introducing it into the hole. If cement or other plugs were used, state the character of same and depth placed, from feet to feet for each plug set.
Fill with gravel to 3550' 5 sacks cement on top of gravel. Fill with heavy mud by Halliburton pump truck to 310' with 100 sacks cement on top. Cement to bottom of cellar

RECEIVED
STATE CORPORATION COMMISSION
OCT 27 1950
CONSERVATION DIVISION
Wichita, Kansas

(If additional description is necessary, use BACK of this sheet)
Correspondence regarding this well should be addressed to Sterling Drilling Company
Address Sterling, Kansas

STATE OF Kansas, COUNTY OF Rice, ss.
Rollin Mead (employee of owner) or (owner or operator) of the above-described well, being first duly sworn on oath, says: That I have knowledge of the facts, statements, and matters herein contained and the log of the above-described well as filed and that the same are true and correct. So help me God.

(Signature) Rollin Mead

(Address)

SUBSCRIBED AND SWORN to before me this 26th day of October, 1950.

F. J. [Signature]
Notary Public.

My commission expires 9-17-53

PLUGGING
BOOK PAGE 38 LINE 16

STERLING DRILLING CO.

STERLING, KANSAS

WELL LOG -----#1 VAN WINKLE

Location- SW/4 NW/4 SW/4 of Section 23-21S-14W, Stafford County, Kansas.

Owner - Messrs. J. A. Davis and J. H. Child, Et Al
Contractor - Sterling Drilling CompanyCommenced - 9-24-50
Completed - 10-9-50 (w/r)
Completed - 10-21-50 (w/ct)
Total Depth - 3779' (w/r) (w/ct)ELEVATION - 1934 DFLOG


0- 310	Surface Hole
310- 370	Shale
370- 830	Red Bed and Sand
830- 860	Anhydrite
860-1240	Shale and Red Bed
1240-1505	Shale
1505-1710	Lime and Shale
1710-2170	Lime
2170-2630	Lime and Shale
2630-2730	Shale
2730-2890	Shale and Lime
2890-3140	Lime
3140-3185	Lime and Shale
3185-3325	Lime
3325-3390	Shale
3390-3640	Lime
3640-3710	Lime and Shale
3710-3735	Lime
3735-3765	Lime and Shale
3765-3779	Arbuckle

CASING RECORD310' of 8-5/8" Surface Pipe
Cemented with 175 Sacks Cement
3779' of 5 1/2" casing, cemented
with 100 sacks cement.

Acidized with 1000 gals. acid

PERFORATED:10 shots from 3598' to 3606'
24 shots from 3576' to 3580'
24 shots from 3559' to 3564'PRODUCTION:

Dry and Abandoned

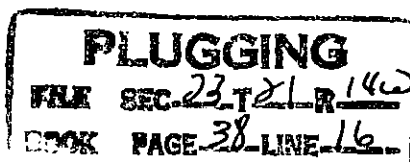

RECEIVED
STATE CORPORATION COMMISSION
OCT 27 1950
CONSERVATION DIVISION
Wichita, Kansas