


WELL PLUGGING RECORD

Give All Information Completely  
Make Required Affidavit  
Mail or Deliver Report to:  
Conservation Division  
State Corporation Commission  
800 Bittling Bldg.  
Wichita, Kans.

NORTH

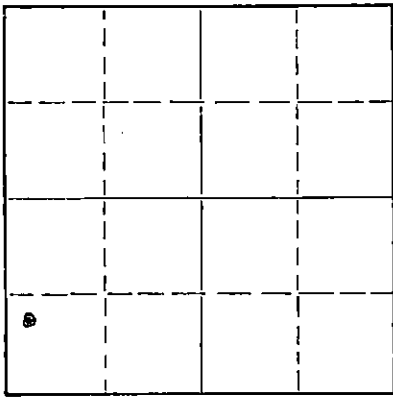

Locate well correctly on above  
Section Plat

Stafford County. Sec. 23 Twp. 21 Rge. 11 (E) W (W)  
Location as "NE/CNW/SW" or footage from lines NW-SW-SW  
Lease Owner The Lotus Oil Company  
Lease Name Van Winkle Well No. 1  
Office Address 900 Riss Bldg., Kansas City, 5, Mo.  
Character of Well (completed as Oil, Gas or Dry Hole) Oil Well  
Date well completed July 19 19 50  
Application for plugging filed August 22 19 56  
Application for plugging approved August 24 19 56  
Plugging commenced September 27 19 56  
Plugging completed September 12 19 56  
Reason for abandonment of well or producing formation No Fluid

If a producing well is abandoned, date of last production Sept 5 19 56  
Was permission obtained from the Conservation Division or its agents before plugging was commenced? Yes

Name of Conservation Agent who supervised plugging of this well R. M. Brundrege  
Producing formation Kansas City Depth to top 3419 Bottom 3610 Total Depth of Well 3784 Feet  
Show depth and thickness of all water, oil and gas formations.

OIL, GAS OR WATER RECORDS

CASING RECORD

FORMATION	CONTENT	FROM	TO	SIZE	PUT IN	PULLED OUT
		0	238	8-5/8	238	None
		0	3768 1/2	5-1/2	3768 1/2	3066'

Describe in detail the manner in which the well was plugged, indicating where the mud fluid was placed and the method or methods used in introducing it into the hole. If cement or other plugs were used, state the character of same and depth placed, from \_\_\_\_\_ feet to \_\_\_\_\_ feet for each plug set.

Plug back with sand to 3560'  
Dumped 5 sacks cement  
Squeeze surface pipe with 20 sacks mud & 90 sacks cement  
Set rock bridge at 25' & dumped cement to top of surface

(If additional description is necessary, use BACK of this sheet)

Name of Plugging Contractor E & I Casing Pulling Co  
Address Great Bend, Kansas

STATE OF Kansas, COUNTY OF Pawnee, ss.

J. L. Haines (employee of owner) ~~Kansas Operator~~ of the above-described well, being first duly sworn on oath, says: That I have knowledge of the facts, statements, and matters herein contained and the log of the above-described well as filed and that the same are true and correct. So help me God.

(Signature) J. L. Haines

(Address) Box 30 Lamed Kans

SUBSCRIBED AND SWORN TO before me this 9th day of Sept 1956

My commission expires 7-11-57

Notary Public.

PLUGGING  
FILE SEC 23 T. 21 R. 11  
BOOK PAGE 92 LINE 44

OCT 12 1956  
CONSERVATION DIVISION  
Wichita, Kansas

DRILLERS LOG

COMPANY: Crown Oil Company Inc

Location: NW-SW-SW Section 23-21-14  
Stafford County, Kansas

Contractor: Hilton Drilling Co

Elevation 1935 D.F.

FARM NAME: VAN WINKLE # 1

COMMENCED: ~~6-17-50~~

CASING USED: 8-5/8" at 238' W/200 Sks

COMPLETED: 7-3-50

5 1/2" at 3768 1/2' W/100 Sks

Surface Sand & Shale	190'
Sand Rock	215'
Shale & Shells	238'
Shale & Shells	325'
Sand	350'
Shale & Shells	390'
Red Bed & Shale	535'
Sand & Shale	625'
Red Bed	630'
Sandy Red Bed	780'
Anhydrite	810'
Red Bed & Shells	950'
Shale, Shells & Salt	1175'
Shale & Shells	1585'
Shale, Shells & Ln Strks	1745'
Shale & Lime Shells	1860'
Shale & Lime	1890'
Chert	1900'
Lime	1920'
Lime, Shale & Sand Strks	2045'
Lime (Broken)	2220'
Lime & Shale	2300'
Lime (Broken)	2390'
Lime & Shale	2463'
Lime & Shale	2565'
Shale & Lime Shells	2720'
Shale & Lime	2850'
Sand & Shale	2913'
Shale & Shells	2960'
Shale & Lime	3035'
Lime	3688'
Lime & Chert	3705'

Chert & Shale	3732'
Lime	3769'
RTD	3769'
Cable Tool TD	3784'

GEOLOGICAL TOPS

Heebner Shale	3280'
Brown Lime	3400'
Lansing (White)	3419'
Viola	3681'
Simpson	3722'
Arbuckle	3767'

PLUGGING

FILE: SEC. 23 T. 21 R. 14W

BOOK: PAGE 92 LINE 44

AUG 2 1950

CONSERVATION DIVISION  
Wichita, Kansas