


WELL PLUGGING RECORD

Give All Information Completely
Make Required Affidavit
Mail or Deliver Report to:
Conservation Division
State Corporation Commission
212 North Market, Insurance Bldg.
Wichita, Kansas

Stafford County, Sec. 31 Twp. 21 Rge. 14 ~~W~~ W (W)
Location as "NE/CNWxSWx" or footage from lines SE NW NE
Lease Owner Hellar Drilling Co.
Lease Name Love Well No. 1
Office Address _____
Character of Well (completed as Oil, Gas or Dry Hole) Dry Hole
Date well completed December 17 19 61
Application for plugging filed December 17 19 61
Application for plugging approved December 17 19 61
Plugging commenced December 17 19 61
Plugging completed December 17 19 61
Reason for abandonment of well or producing formation Dry Hole

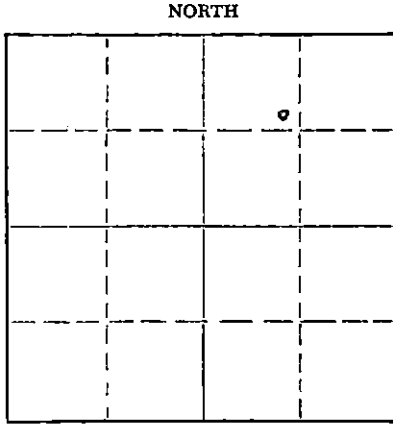

Locate well correctly on above Section Plat

If a producing well is abandoned, date of last production 19____
Was permission obtained from the Conservation Division or its agents before plugging was commenced? _____

Name of Conservation Agent who supervised plugging of this well LaCamp
Producing formation _____ Depth to top _____ Bottom _____ Total Depth of Well 3,854 Feet
Show depth and thickness of all water, oil and gas formations.

OIL, GAS OR WATER RECORDS

CASING RECORD

FORMATION	CONTENT	FROM	TO	SIZE	PUT IN	PULLED OUT

Describe in detail the manner in which the well was plugged, indicating where the mud fluid was placed and the method or methods used in introducing it into the hole. If cement or other plugs were used, state the character of same and depth placed, from _____ feet to _____ feet for each plug set.

Set Haliburton plug, 1/4 sks hulls and 20 sks cement at 240'. Mud to 35'
set Haliburton plug, 1/4 sks hulls and 10 sks cement. 2 sks in rat hole.

RECEIVED
STATE CORPORATION COMMISSION

JAN 15 1962

CONSERVATION DIVISION
Wichita, Kansas

(If additional description is necessary, use BACK of this sheet)

Name of Plugging Contractor Duke Burt Drilling Co.
Address Great Bend, Kansas

STATE OF KANSAS, COUNTY OF BARTON, ss.
Duke G. Burt (employee or owner) or (owner or operator) of the above-described well, being first duly sworn on oath, says: That I have knowledge of the facts, statements, and matters herein contained and the log of the above-described well as filed and that the same are true and correct. So help me God.

(Signature) Duke Burt
1823 Washington, Great Bend, Kansas
(Address)

SUBSCRIBED AND SWORN TO before me this 21 day of December, 19 61

My commission expires August 26, 1965

Zona George
Notary Public.



15.185.19476-0000

RECEIVED
STATE COMMISSION

JAN 1 1962

CONSERVATION DIVISION
Wichita, Kansas

HELLAR DRILLING CO., INC.
1014 Union Center
Wichita, Kansas

Well: Love No. 1
Commenced R.D.: 12/7/61
Completed R.D.: 12/17/61
Total Depth: 3,854'
Casing: 260' of 8 5/8" 8 rd thd. 28#

Sec. 31-21-14
Stafford County, Kansas
Elevation:
Initial Prod: D & A
Contractor: DUKE BURT
DRILLING CO.

Strata	Depth
Sand	0- 212"
Shale	212- 340
Sand w/redbed	340- 874
Anhydoite	874- 898
Shale	898-1200
Salt	1200-1480
Shale & lime	1480-1725
Lime w/shale streaks	1725-2738
Shale & lime	2738-2965
Lime & shale	2965-3255
Lime	3255-3335
Lime & shale	3335-3430
Lime	3430-3508
Lime & shale	3508-3562
Lime	3562-3715
Cherty Lime (Viola)	3715-3774
Shale (Simpson)	3774-3780
Lime	3780-3841
Lime (Arbuckle)	3841-3854

I hereby certify that the above is a true and correct log of said well as reflected by daily drilling reports.

DUKE BURT DRILLING CO.

By



Signed and sworn to in my presence this 21 day of December, 1961.



Notary Public

My Commission Expires: August 26, 1965