


STATE OF KANSAS
STATE CORPORATION COMMISSION

WELL PLUGGING RECORD

Give All Information Completely.
Make Required Affidavit
Mail or Deliver Report to
Conservation Division
State Corporation Comm.
245 North Water
Wichita, KS 67202

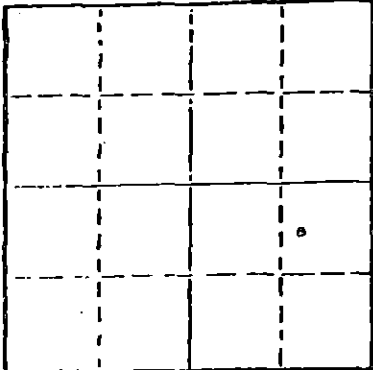

Locate well correctly on above
Section Plat

Barton County. Sec. 20 Twp. 16 Rge. 12 E/W
Location as "NE/CNW $\frac{1}{4}$ SW $\frac{1}{4}$ " or footage from lines
C W/2 NE SE
Lease Owner Palomino Petroleum
Lease Name Christians Well No. 4
Office Address 500 Insurance Bldg., Wichita, Kansas
Character of Well (Completed as Oil, Gas or Dry Hole) 67202
oil
Date Well completed Aug. 26 1956
Application for plugging filed April 3 1978
Application for plugging approved April 4 1978
Plugging commenced May 24 1978
Plugging completed June 14 1978
Reason for abandonment of well or producing formation
depleted
If a producing well is abandoned, date of last production 19

Was permission obtained from the Conservation Division or
its agents before plugging was commenced? yes

Name of Conservation Agent who supervised plugging of this well Duane Rankin
Producing formation Depth to top Bottom Total Depth of Well 3388'
Show depth and thickness of all water, oil and gas formations.

OIL, GAS OR WATER RECORDS

CASING RECORD

FORMATION	CONTENT	FROM	TO	SIZE	PUT IN	PULLED OUT
		0	373'	8 5/8"	373'	none
			3372'	5 1/2"	3372'	2537.39

Describe in detail the manner in which the well was plugged, indicating where the mud fluid
was placed and the method or methods used in introducing it into the hold. If cement or other
plugs were used, state the character of same and depth placed, from feet to
feet for each plug set.

Sanded back to 3340' and dumped 5 sacks of cement.

Sun Cementing Inc. plugged well pumping in 5 sacks of hulls, 25 sacks of
gel and 100 sacks of cement.

(If additional description is necessary, use BACK of this sheet)

Name of Plugging Contractor PIPE PULLERS, INC.

STATE OF KANSAS COUNTY OF BARTON, ss.
Evelyn Roth (employee of owner) or (owner or operator)
of the above-described well, being first duly sworn on oath, says: That I have knowledge of
the facts, statements, and matters herein contained and the log of the above-described well
as filed and that the same are true and correct. So help me God.

(Signature) Evelyn Roth
Ellinwood, Kansas

(Address)

SUBSCRIBED AND SWORN TO before me this 19th day of June, 1978.

My commission expires

JENNY KASSELMAN
NOTARY PUBLIC
BARTON COUNTY, KANSAS
MY COMM. EXP. JULY 16, 1978

RECEIVED
STATE CORPORATION COMMISSION
Jenny Kasselman
Notary Public.

JUN 20 1978

CONSERVATION DIVISION
Wichita, Kansas

15-009-07431-00-00

WELL LOG BUREAU—KANSAS GEOLOGICAL SOCIETY
503 East Murdock,
Wichita, Kansas

COPY

Company- FRANCO CENTRAL OIL COMPANY
Farm- Christians No. 4SEC. 20 T. 16 R. 12W
C W/2 NE SE

Total Depth. 3388'

Comm. 8-18-56

Shot or Treated.


Comp. 8-26-56

Contractor. Lewis Drilling Company

Issued. 10-20-56

County Barton

KANSAS

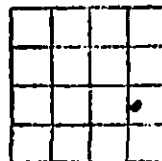

Elevation. 1928' RB

Production. 25 BOPD

Figures indicate Bottom of Formations.

clay & sand	100
shale	373
gray shale	500
red bed	820
Anhydrite	860
salt & shells	1465
lime & shale	2955
lime	2995
lime & shale	3100
lime	3376
lime	3388

Total Depth

TOPS:	
Heebner	3016
Toronto	3032
Brown lime	3101
Lansing	3118
Arbuckle	3372

RECEIVED
STATE GEOLOGICAL SURVEY
APR 04 1978
GEOLOGICAL SURVEY
Wichita, Kansas