


STATE OF KANSAS
STATE CORPORATION COMMISSION

Give All Information Completely
Make Required Affidavit
Mail or Deliver Report to:
Conservation Division
State Corporation Commission
800 Bittling Building
Wichita, Kansas

15-009-66291-00-00

WELL PLUGGING RECORD

NORTH

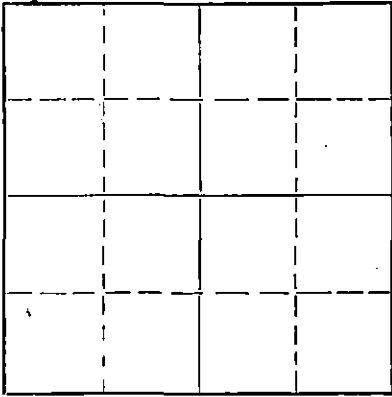

Locate well correctly on above
Section Plat

Barton

County, Sec. 20 Twp. 16S Rge. 12W (E) (W)

Location as "NE/CNW/SW" or footage from lines SE SE SE

Lease Owner Franco Central Oil Company

Lease Name Beaver Townsite

Well No. 1

Office Address Fourth National Bank Building, Wichita, Kansas

Character of Well (completed as Oil, Gas or Dry Hole) Dry Hole

Date well completed 11-23-19 53

Application for plugging filed 11-23-19 53

Application for plugging approved 11-23-19 53

Plugging commenced 11-23-19 53

Plugging completed 11-23-19 53

Reason for abandonment of well or producing formation

If a producing well is abandoned, date of last production 19

Was permission obtained from the Conservation Division or its agents before plugging was commenced? yes

Name of Conservation Agent who supervised plugging of this well C. D. Stough

Producing formation Depth to top Bottom Total Depth of Well 3425 Feet

Show depth and thickness of all water, oil and gas formations.

OIL, GAS OR WATER RECORDS

CASING RECORD

FORMATION	CONTENT	FROM	TO	SIZE	PUT IN	PULLED OUT
	LOG ATTACHED					

Describe in detail the manner in which the well was plugged, indicating where the mud fluid was placed and the method or methods used in introducing it into the hole. If cement or other plugs were used, state the character of same and depth placed, from feet to feet for each plug set.

Filled hole with heavy mud to 300', set plug and cemented with 20 sacks through drill pipe. Filled hole with mud to 40', set plug and cemented to bottom of cellar with 10 sacks

(If additional description is necessary, use BACK of this sheet)
Name of Plugging Contractor The Carl Todd Drilling Company
Address 404 KFH Building, Wichita, Kansas

STATE OF Kansas, COUNTY OF Sedgwick, ss.

L. L. Livingston (employee of owner) or (owner or operator) of the above-described well, being first duly sworn on oath, says: That I have knowledge of the facts, statements, and matters herein contained and the log of the above-described well as filed and that the same are true and correct. So help me God.

(Signature)

L. L. Livingston

512 Fourth National Bank Bldg., Wichita, Kans.


(Address)

SUBSCRIBED AND SWORN to before me this 3rd day of December, 19 53

My commission expires October 21, 1957

Notary Public.

24-2675-5 2-52-20M

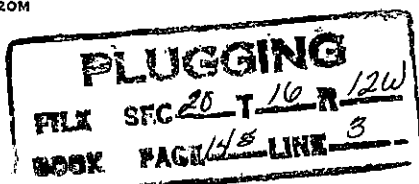

15-009-06291-00-00

FRANCO CENTRAL OIL COMPANY
 #1 Beaver Townsite
 SE SE SE Sec. 20-16S-12W
 Barton County, Kansas

ELEVATION: 1919 DF

COMMENCED: November 11, 1953
 COMPLETED: November 23, 1953

0 - 250	Post rock, shale and shells
250 - 270	Shale
270 - 285	Sand
285 - 378	Shale and shells
378 - 540	Shale and shells
540 - 615	Shale and sand
615 - 825	Red bed
825 - 850	Anhydrite
850 - 1249	Red bed and shale
1249 - 1500	Red bed and shale
1500 - 1575	Shale and lime
1575 - 1715	Lime and shale
1715 - 1885	Shale and lime
1885 - 1985	Lime and shale
1985 - 2065	Lime and shale
2065 - 2215	Lime and shale
2215 - 2345	Shale and lime
2345 - 2430	Shale and lime
2430 - 2580	Lime and shale
2580 - 2655	Shale and lime
2655 - 2755	Shale and lime
2755 - 2820	Lime and shale
2820 - 2885	Lime
2885 - 2925	Lime
2925 - 2995	Lime
2995 - 3065	Lime
3065 - 3100	Lime
3100 - 3130	Lime
3130 - 3186	Lime
3186 - 3243	Lime
3243 - 3300	Lime
3300 - 3347	Lime
3347 - 3355	Lime
3355 - 3396	Cong.
3396 - 3404	Cong.
3404 - 3425	Arbuckle
3425	Rotary Total Depth

CASING RECORD

Set 8-5/8" surface casing @
 378', cemented with 225 sac

TOPS

Heobner	3003
Brown Lime	3091
Lansing	3105
B/Kansas City	3349
Arbuckle	3404

I hereby certify that the above log is true and correct to the best of my knowledge and belief.

THE CARL TODD DRILLING COMPANY

BY

Carl Todd

STATE COM.

CONV.

VISION

PLUGGING

FILE SEC 20-16S-12W
 BOOK PAGE 145 LINE 3