


STATE OF KANSAS
STATE CORPORATION COMMISSION

WELL PLUGGING RECORD

Give All Information Completely
Make Required Affidavit
Mail or Deliver Report to:
Conservation Division
State Corporation Commission
800 Bittling Building
Wichita, Kansas

Stafford County. Sec. 29 Twp. 21 Rge. (E) 11 (W)
Location as "NE/CNW $\frac{1}{4}$ /SW $\frac{1}{4}$ " or footage from lines SW $\frac{1}{4}$ SW $\frac{1}{4}$ NE $\frac{1}{4}$
Lease Owner Edw. H. Isern et al
Lease Name Smith Well No. 1
Office Address Box 45, Ellinwood, Kansas
Character of Well (completed as Oil, Gas or Dry Hole) Dry Hole
Date well completed 2-14-51 19
Application for plugging filed 2-14-51 19
Application for plugging approved 2-14-51 19
Plugging commenced 2-14-51 19
Plugging completed 2-14-51 19
Reason for abandonment of well or producing formation
If a producing well is abandoned, date of last production 19
Was permission obtained from the Conservation Division or its agents before plugging was commenced? Yes

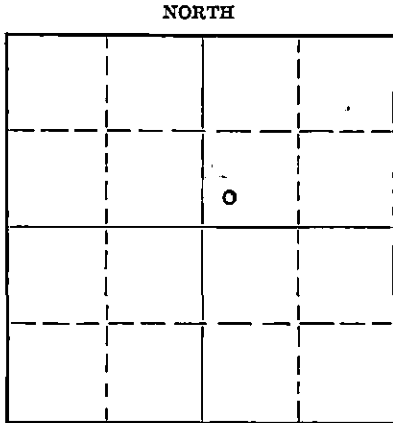

Locate well correctly on above
Section Flat

Name of Conservation Agent who supervised plugging of this well C. D. Stough
Producing formation Depth to top Bottom Total Depth of Well 3596 Feet
Show depth and thickness of all water, oil and gas formations.

OIL, GAS OR WATER RECORDS

CASING RECORD

Formation	Content	From	To	Size	Put In	Pulled Out
Surface Pipe		0	217'	8 5/8"	217'	None

Describe in detail the manner in which the well was plugged, indicating where the mud fluid was placed and the method or methods used in introducing it into the hole. If cement or other plugs were used, state the character of same and depth placed, from feet to feet for each plug set.

Filled hole with heavy mud. Set rock bridge at 217'. Set cement plug with 15 sacks cement from 217' up. Bridged at 35' and cemented with 10 sacks cement, cement returning to base of cellar.

RECEIVED
STATE CORPORATION COMMISSION
FEB 22 1951
CONSERVATION DIVISION
Wichita, Kansas

(If additional description is necessary, use BACK of this sheet)

Correspondence regarding this well should be addressed to G. W. Keyes Drilling Company
Address Box 92, Ellinwood, Kansas

STATE OF KANSAS, COUNTY OF BARTON, ss.
Edw. H. Isern, Part Owner (employee of owner or owner or operator) of the above-described well, being first duly sworn on oath, says: That I have knowledge of the facts, statements, and matters herein contained and the log of the above-described well as filed and that the same are true and correct. So help me God
(Signature) *Edw. H. Isern*
Ellinwood, Kansas
(Address)

SUBSCRIBED AND SWORN to before me this 20th day of February, 1951.

George A. Meyer
Notary Public.

My commission expires February 10, 1955

PLUGGING
FILE SEC V9T Y1 R 142
BOOK PAGE 62 LINE 42

WELL LOG

Edw. H. Isern et al - OWNERS - Smith #1
 SW¹/₄ SW³/₄ NE¹/₄ Section 29, Township 21, Range 11W.
 Stafford County, Kansas

Elevation: 1744 DF

Figures indicate bottom of formation
 0 to 90 sand

Pipe Record:

8 5/8" set at 217'

Tops - corrected 2' to derrick #floor

Heebner 2967
 Brown lime 3099
 Lansing 3121
 Conglomerate 3396
 Arbuckle 3587

218 red bed
 480 red bed and shells
 500 anhydrite
 760 shale and shells
 1105 red bed and shale
 1300 salt and shale
 1415 lime and shale
 1575 sandy lime
 2260 lime and shale
 2450 broken lime
 2905 lime and shale
 2975 lime
 3075 lime and shale
 3365 lime
 3435 lime, shale and conglomerate
 3578 conglomerate
 3585 cherty conglomerate
 3596 lime
 3596 Total Depth - D & A

Rotary commenced 2-2 -51
 Rotary completed 2-15-51

STATE OF KANSAS)
 COUNTY OF BARTON) SS

I, Edw. H. Isern, Part Owner of the above-described well, being first duly sworn on oath, declare: That I have knowledge of the facts, statements and matters herein contained pertaining to the log of the above-described well, as filed, and that the same are true and correct.

Edw. H. Isern

Subscribed and Sworn to before me this 20th day of February, 1951.

Georgel Meyer
 Notary Public

My commission expires Feb. 10, 1955.

RECEIVED
 STATE CORPORATION COMMISSION
 FEB 22 1951
 CONSERVATION DIVISION
 Wichita, Kansas

PLUGGING
 FILE SEC 29T 21R 11W
 BOOK PAGE 62 LINE 42