


WELL PLUGGING RECORD

Give All Information Completely
Make Required Affidavit
Mail or Deliver Report to:
Conservation Division
State Corporation Commission
212 North Market, Insurance Bldg.
Wichita, Kansas

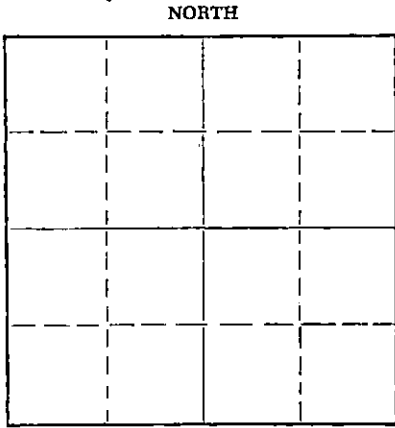

Stafford County, Sec. 29 Twp. 21S Rge. 11W (E) (W)
Location as "NE/CNW/SW" or footage from lines NW NW NE
Lease Owner Hellar Drilling Company, Inc.
Lease Name Smith Estate Well No. 1
Office Address 1014 Union Center, Wichita, Kansas
Character of Well (completed as Oil, Gas or Dry Hole) Dry Hole
Date well completed June 13, 1960 19
Application for plugging filed June 13, 19 60
Application for plugging approved June 13, 19 60
Plugging commenced June 13, 19 60
Plugging completed June 13, 19 60
Reason for abandonment of well or producing formation Dry Hole

If a producing well is abandoned, date of last production 19
Was permission obtained from the Conservation Division or its agents before plugging was commenced? Yes, orally

Name of Conservation Agent who supervised plugging of this well Frank Broadfoot
Producing formation _____ Depth to top _____ Bottom _____ Total Depth of Well 3543 Feet
Show depth and thickness of all water, oil and gas formations.

OIL, GAS OR WATER RECORDS

CASING RECORD

FORMATION	CONTENT	FROM	TO	SIZE	PUT IN	PULLED OUT
		0	218'	8-5/8"	224,34'	None

Describe in detail the manner in which the well was plugged, indicating where the mud fluid was placed and the method or methods used in introducing it into the hole. If cement or other plugs were used, state the character of same and depth placed, from _____ feet to _____ feet for each plug set.

Filled with mud to 200'. Set first plug at 200' with 20 sacks cement, filled to 40' with mud and set second plug with 10 sacks cement. Filled to top of surface.

RECEIVED
STATE CORPORATION COMMISSION
JUN 28 1960
CONSERVATION DIVISION
Wichita, Kansas

(If additional description is necessary, use BACK of this sheet)

Name of Plugging Contractor Hellar Drilling Company, Inc.
Address Above

STATE OF KANSAS, COUNTY OF SEDGWICK, ss.
D. L. Hellar (employee of owner) of the above-described well, being first duly sworn on oath, says: That I have knowledge of the facts, statements, and matters herein contained and the log of the above-described well as filed and that the same are true and correct. So help me God.

(Signature) *D. L. Hellar*

1014 Union Center, Wichita, Kansas
(Address)

SUBSCRIBED AND SWORN TO before me this 22nd day of June, 19 60

Shanda Lou Bruce
Notary Public.

My commission expires March 6, 1961.



DRILLER'S WELL LOG

OWNER:
LEASE:
LOCATION:

COMMENCED:
COMPLETED:
CASING:

RECEIVED
STATE CORPORATION COMMISSION

JUN 28 1960

CONSERVATION DIVISION
Wichita, Kansas

Hellar Drilling Company, Inc.
Smith Estate
NW NW NE, Sec. 29-21S-11W
Stafford County, Kansas
June 3, 1960
June 13, 1960
Set 8-5/8" Surface Casing
@ 218' w/250 sacks cement

0 - 101	Sand
101 - 487	Red bed
487 - 780	Anhydrite
780 - 900	Red bed, shale
900 - 1280	Shale
1280 - 1405	Shale, lime
1405 - 1570	Lime
1570 - 2580	Lime & Shale
2580 - 2855	Howard lime
2855 - 3000	Topeka lime
3000 - 3080	Shale
3080 - 3182	Lime & Shale
3182 - 3220	Bansing Kansas City
3220 - 3405	Lime
3405 - 3459	Conglomerate
3459 - 3493	Lime, shale
3493 - 3543	Arbuckle
3543	Rotary Total Depth
	D & A

STATE OF KANSAS)
) SS
COUNTY OF SEDGWICK)

I, D. L. Hellar, do hereby certify that the above and foregoing is a true and correct copy of the log of the SMITH ESTATE, located NW NW NE, Section 29-21S-11W, Stafford County, Kansas, as reflected by the files of the Hellar Drilling Company, Inc.

HELLAR DRILLING COMPANY, INC.

BY *D. L. Hellar*
D. L. Hellar, President

Subscribed and sworn to before me, a Notary Public, in and for Sedgwick County, Kansas, this 17th day of June, 1960.

Wanda Lou Bruce
Notary Public

My commission expires March 6, 1961.