


Give All Information Completely
Make Required Affidavit
Mail: Deliver Report to
Conservation Division
State Corporation Commission
1001 No. Broadway
Wichita, Kansas

WELL PLUGGING RECORD

NORTH

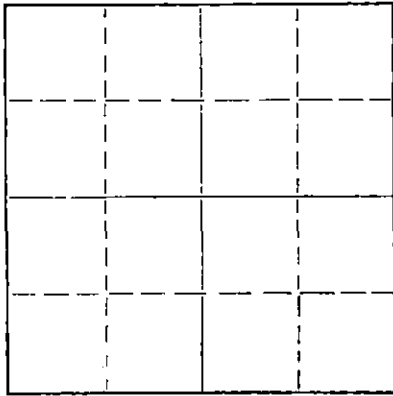

Locate well correctly on above
Section Plat

Stafford County. Sec. 29 Twp. 21S Rge. 11 (E) W (W)
Location as "NE/CNW*SW*" or footage from lines C/SE NE
Lease Owner Kansas Petroleum, Inc.
Lease Name Manning Well No. 1
Office Address 720 Bitting Bldg., Wichita, Kansas
Character of Well (completed as Oil, Gas or Dry Hole) Dry Hole
Date well completed December 17 1962
Application for plugging filed December 17 1962
Application for plugging approved December 17 1962
Plugging commenced December 17 1962
Plugging completed December 17 1962
Reason for abandonment of well or producing formation Dry Hole

If a producing well is abandoned, date of last production _____ 19____
Was permission obtained from the Conservation Division or its agents before plugging was commenced? Yes

Name of Conservation Agent who supervised plugging of this well Donald Truan, Russell, Kansas
Producing formation _____ Depth to top _____ Bottom _____ Total Depth of Well _____ Feet
Show depth and thickness of all water, oil and gas formations.

OIL, GAS OR WATER RECORDS

CASING RECORD

FORMATION	CONTENT	FROM	TO	SIZE	PUT IN	PULLED OUT
	8-5/8"	0	284'	8-5/8"		
	284'					

Describe in detail the manner in which the well was plugged, indicating where the mud fluid was placed and the method or methods used in introducing it into the hole. If cement or other plugs were used, state the character of same and depth placed, from _____ feet to _____ feet for each plug set.

Hole plugged as follows; plugged at 280' with 25 sacks of cement and 1/4 sack of hulls to 40'; plugged with 1/4 sack of hulls and 10 sacks of cement. Job completed at 9:00 A. M. December 17, 1962.

RECEIVED
STATE CORPORATION COMMISSION

DEC 20 1962

CONSERVATION DIVISION
Wichita, Kansas

(If additional description is necessary, use BACK of this sheet)

Name of Plugging Contractor Strata Drilling, Inc.
Address P. O. Box 355, Great Bend, Kansas

STATE OF KANSAS, COUNTY OF BARTON, ss.
Ralph Schuyler (employee of owner) or ~~(owner or operator)~~ of the above-described well, being first duly sworn on oath, says: That I have knowledge of the facts, statements, and matters herein contained and the log of the above-described well as filed and that the same are true and correct. So help me God. STRATA DRILLING, INC.

(Signature) Ralph Schuyler
Box 355, Great Bend, Kansas
(Address)

SUBSCRIBED AND SWORN TO before me this 18th day of December 1962

commission expires December 14, 1965

Elaine H. Taylor
Elaine H. Taylor Notary Public

DRILLERS LOG

#1 Manning

CASING RECORD:
284' of new 8-5/8"
surface casing

COMPANY: Kansas Petroleum, Inc.
CONTRACTOR: Strata Drilling, Inc.

DESCRIPTION: C/SE NE
Section 29-21S-11W
Stafford Co., Kansas

TOTAL DEPTH:
3488'

COMMENCED: December 5, 1962

COMPLETED: December 17, 1962

D. & A.

<u>FORMATION</u>	<u>FROM</u>	<u>TO</u>	<u>REMARKS</u>
Sand & Red Bed	0	215	Ran 284' of new 8-5/8" surface casing; set and cemented at 284' with 280 sacks of regular cement, 2% gel, 2% C. C. and 1/4 lb. flo-seal per sack of cement. Plug down at 2:30 A. M. December 8, 1962. Cement circ.
Red Bed	215	320	
Shale	320	1313	
Lime & Shale	1313	2345	
Shale	2345	2545	
Shale & Lime	2545	2900	
Lime	2900	2940	
Shale & Lime	2940	3125	
Lime	3125	3170	
Lime & Shale	3170	3215	
Lime	3215	3330	
Lime & Shale	3330	3385	
Chert & Lime	3385	3410	
Sand	3410	3428	
Sand & Shale	3428	3435	Ran 6 drill stem tests.
Sand, Shale & Lime	3435	3466	D. & A.
Lime	3466	3488	

Total Depth 3488'

Plugged as follows; plugged at 280' with 25 sacks of cement and 1/4 sack of hulls to 40; plugged with 1/4 sack of hulls and 10 sacks of cement. Job completed at 9:00 A. M. December 17, 1962.

DEC 20 1962

STATE OF KANSAS)
) ss.
COUNTY OF BARTON)

I certify that this is a true and correct copy of the above log to the best of my knowledge.

STRATA DRILLING, INC.

Ralph Schuyler
Ralph Schuyler

Subscribed and sworn to before me this 18th day of December, 1962.

Elaine H. Taylor
Elaine H. Taylor, Notary Public

Commission Expires:

December 14, 1965