


STATE OF KANSAS
STATE CORPORATION COMMISSION

WELL PLUGGING RECORD

Give All Information Completely
Make Required Affidavit
Mail or Deliver Report to:
Conservation Division
State Corporation Commission
211 No. Broadway
Wichita, Kansas

Stafford County. Sec. 22 Twp. 21S Rge. (E) 11 (W)

NORTH

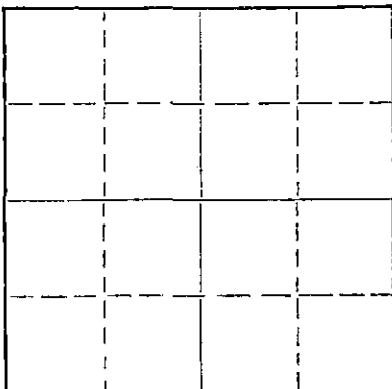

Locate well correctly on above
Section Plat

Location as "NE/CNW/SW" or footage from lines SW NW SW
Lease Owner Raymond Oil Company, Inc.
Lease Name Ruan Well No. 1
Office Address 410 Fourth National Bank Bldg., Wichita, Kansas
Character of Well (completed as Oil, Gas or Dry Hole) Dry Hole
Date well completed May 25, 1966 19
Application for plugging filed May 31, 1966 19
Application for plugging approved May 27, 1966 19
Plugging commenced May 25, 1966 19
Plugging completed May 25, 1966 19
Reason for abandonment of well or producing formation

If a producing well is abandoned, date of last production 19
Was permission obtained from the Conservation Division or its agents before plugging was commenced? Yes

Name of Conservation Agent who supervised plugging of this well Archie Elving
Producing formation Depth to top Bottom Total Depth of Well Feet
Show depth and thickness of all water, oil and gas formations.

OIL, GAS OR WATER RECORDS

CASING RECORD

FORMATION	CONTENT	FROM	TO	SIZE	PUT IN	PULLED OUT
				10 3/4"	206'	

Describe in detail the manner in which the well was plugged, indicating where the mud fluid was placed and the method or methods used in introducing it into the hole. If cement or other plugs were used, state the character of same and depth placed, from feet to feet for each plug set.

30 Sacks at 190'
15 Sacks at 40'
2 Sacks in rat hole.

RECEIVED
STATE CORPORATION COMMISSION

JUN - 8 1966

CONSERVATION DIVISION
Wichita, Kansas

Name of Plugging Contractor Raymond Oil Company, Inc. (If additional description is necessary, use BACK of this sheet)
Address 410 Fourth National Bank Bldg., Wichita, Kansas

STATE OF Kansas, COUNTY OF Sedgwick, ss.
Wm. M. Raymond (owner or operator) of the above-described well, being first duly sworn on oath, says: That I have knowledge of the facts, statements, and matters herein contained and the log of the above-described well as filed and that the same are true and correct. So help me God.

(Signature) *Wm. M. Raymond*
410 Fourth National Bank Bldg.
(Address)

SUBSCRIBED AND SWORN TO before me this 7th day of June, 1966

My commission expires February 15, 1967 Ronnie Donnelly Notary Public.

RAYMOND OIL COMPANY, INC.
 #1 RUGAN
 SW NW SW Sec. 22-21S-11W
 Stafford County, Kansas

ELEVATION: 1741 KB
 1739 DF
 1737 GL

Drilling Contractor: Company Tools
 Date Commenced: May 14, 1966
 Date Completed: May 25, 1966

Casing Record:
10-3/4" @ 206' w/325 sx.

Figures Indicate Bottom of Formation

Sand & Red Bed	205
Red Bed	451
Anhydrite	473
Shale & Shells	1120
Shale & Shells w/ Srks Lm	1525
Shale w/Lime Streaks	1643
Lime & Shale	2130
Shale w/Lime	2335
Lime & Shale	2500
Lime w/Shale	2551
Shale w/Lime Streaks	2658
Lime & Shale	2865
Chalky Lime & Shale	2927
Lime w/Shale	3000
Lime & Shale	3123
Lime w/Shale	3165
Lime	3341
Lime, Shale & Chert	3351
Sand & Chert	3360
Lime	3390
Arbuckle	3401
RTD	3402

RECEIVED
 STATE CORPORATION COMMISSION
 JUN - 8 1966
 CONSERVATION DIVISION
 Wichita, Kansas

STATE OF KANSAS)
) SS:
 COUNTY OF SEDGWICK)

I hereby certify that the above is true and correct to the best of my knowledge.

Wm. M. Raymond
 Wm. M. Raymond

Subscribed and sworn to before me, this 31st day of May, 1966.

Ronnie Donnelly
 Ronnie Donnelly - Notary Public

My commission expires:
February 15, 1967