

STATE OF KANSAS
STATE CORPORATION COMMISSION


Form CP-4

Give All Information Completely
Make Required Affidavit
Mail or Deliver Report to:
Conservation Division
State Corporation Commission
212 No. Market
Wichita, Kansas 67202

WELL PLUGGING RECORD

Stafford County, Sec. 27 Twp. 21 Rge. 11 (E) (W)
NW NE NW

Location as "NE/CNW&SW" or footage from lines
Lease Owner James D. Mooneyham
Lease Name Erickson #1 Well No.
Office Address Beverly, Kansas
Character of Well (completed as Oil, Gas or Dry Hole)
Date well completed 19
Application for plugging filed 19
Application for plugging approved 19
Plugging commenced 8/30/71 19
Plugging completed 9/1/71 19
Reason for abandonment of well or producing formation depleted.

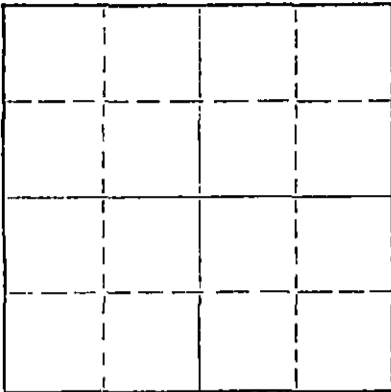

Locate well correctly on above Section Plat

If a producing well is abandoned, date of last production 19
Was permission obtained from the Conservation Division or its agents before plugging was commenced? YES

Name of Conservation Agent who supervised plugging of this well Biberstein
Producing formation Depth to top Bottom Total Depth of Well 3460 Feet

Show depth and thickness of all water, oil and gas formations.

OIL, GAS OR WATER RECORDS

CASING RECORD

| FORMATION | CONTENT | FROM | TO | SIZE | PUT IN | PULLED OUT |
|-----------|---------|------|----|-------|--------|------------|
| | | | | 8-5/8 | 246 | none |
| | | | | 4 1/2 | 3460' | 2810' |
| | | | | | | |
| | | | | | | |
| | | | | | | |
| | | | | | | |
| | | | | | | |
| | | | | | | |
| | | | | | | |

Describe in detail the manner in which the well was plugged, indicating where the mud fluid was placed and the method or methods used in introducing it into the hole. If cement or other plugs were used, state the character of same and depth placed, from feet to feet for each plug set.

Checked hole to 3460', ran sand to 3370' and dumped 4 sacks of cement.
Rigged up over 4 1/2" casing, used overshot for starting nipple. Shot pipe at 3009', 2912', 2816', worked pipe loose and pulled 85 joints. Allied squeezed well with 3 sacks hulls, 15 sacks mud and 100 sacks of cement.

PLUGGING COMPLETE.

RECEIVED
STATE CORPORATION COMMISSION
SEP 9 1971
CONSERVATION DIVISION
Wichita, Kansas

Name of Plugging Contractor (If additional description is necessary, use BACK of this sheet)
KNIGHT CASING PULLING CO., INC.
Address CHASE, KANSAS

STATE OF KANSAS, COUNTY OF RICE, ss.
NOEL J. KNIGHT (employee of owner) or (owner or operator) of the above-described

well, being first duly sworn on oath, says: That I have knowledge of the facts, statements, and matters herein contained and the log of the above-described well as filed and that the same are true and correct. So help me God.

(Signature) Noel Knight
CHASE, KANSAS
(Address)

Subscribed and Sworn to before me this 7th day of September, 1971
MARGARET MELCHER
NOTARY PUBLIC
Rice County, Kansas
My Commission Expires Feb. 15, 1975
Margaret Melcher
Notary Public.

