


WELL PLUGGING RECORD

Give All Information Completely
Make Required Affidavit
Mail or Deliver Report to:
Conservation Division
State Corporation Commission
211 No. Broadway
Wichita, Kansas

NORTH

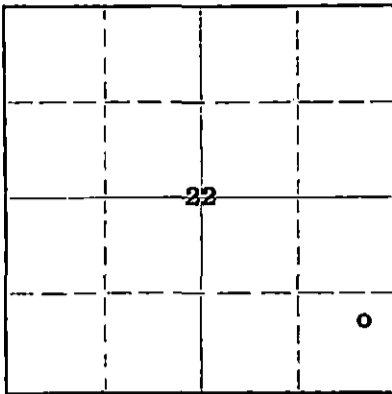

Locate well correctly on above
Section Plat

Stafford County, Sec. 22 Twp 21S Rge. 14W (E) (W)
Location as "NE/CNW&SW&" or footage from lines NE SE SE
Lease Owner Hellar Drilling Company, Inc.
Lease Name Colvin Well No. 1
Office Address 1014 Union Center
Character of Well (completed as Oil, Gas or Dry Hole) Dry Hole
Date well completed Oct. 17, 19 61
Application for plugging filed Oct. 17, 19 61
Application for plugging approved Oct. 17, 19 61
Plugging commenced Oct. 17, 19 61
Plugging completed Oct. 17, 19 61
Reason for abandonment of well or producing formation Dry Hole

If a producing well is abandoned, date of last production _____ 19____
Was permission obtained from the Conservation Division or its agents before plugging was commenced? Yes, orally

Name of Conservation Agent who supervised plugging of this well Frank Broadfoot
Producing formation _____ Depth to top _____ Bottom _____ Total Depth of Well 3796 Feet
Show depth and thickness of all water, oil and gas formations.

OIL, GAS OR WATER RECORDS

CASING RECORD

FORMATION	CONTENT	FROM	TO	SIZE	PUT IN	PULLED OUT
		0	262'	8 5/8"	284'	None

Describe in detail the manner in which the well was plugged, indicating where the mud fluid was placed and the method or methods used in introducing it into the hole. If cement or other plugs were used, state the character of same and depth placed, from _____ feet to _____ feet for each plug set.

Filled hole with mud to 225' set first plug with 1/4 sack hulls and 30 sacks cement.
Filled hole with mud to 35' set second plug with 1/4 sack hulls and 10 sacks cement.

RECEIVED
STATE CORPORATION COMMISSION
NOV 14 1961
CONSERVATION DIVISION
Wichita, Kansas

(If additional description is necessary, use BACK of this sheet)
Name of Plugging Contractor Hellar Drilling Company, Inc.
Address 1014 Union Center, Wichita, Kansas

STATE OF KANSAS, COUNTY OF SEDGWICK, ss.
D.L. Hellar, President of Hellar Drilling Company, Inc. (owner or operator) of the above-described well, being first duly sworn on oath, says: That I have knowledge of the facts, statements, and matters herein contained and the log of the above-described well as filed and that the same are true and correct. So help me God.

(Signature) [Signature]
1014 Union Center
(Address)

SUBSCRIBED AND SWORN TO before me this 6th day of November 19 61

My commission expires March 6, 1965 [Signature] Notary Public.

14

DRILLER'S LOG

COMPANY: Hellar Drilling Company, Inc.
 LEASE: #1 Colvin
 LOCATION: NE SE SE SEC. 22-21S-14W
 Stafford County, Kansas
 COMMENCED: October 8, 1961
 COMPLETED: October 17, 1961
 CASING: Set 8 5/8" surface casing @ 262'
 w/150 sacks cement.

0 - 262	Surface hole
262 - 750	Shale, sand, red bed
750 - 840	Red bed
840 - 863	Anhydrite
863 - 1429	Shale
1429 - 1660	Shale & shells
1660 - 1775	Lime & shale
1775 - 1975	Salt section & Ft. Riley
1975 - 2342	Shale & lime
2342 - 2483	Shale
2483 - 2758	Shale & lime
2758 - 2856	Lime & shale
2856 - 3044	Shale & lime
3044 - 3239	Lime & shale
3239 - 3416	Shale & lime
3416 - 3482	Lansing-Kansas City
3482 - 3624	Lime
3624 - 3680	Lime & chert
3680 - 3704	Viola
3704 - 3773	Chert & shale
3773 - 3782	Shale
3782 - 3796	Arbuckle
3796	Rotary Total Depth
	D & A

RECEIVED
 STATE CORPORATION COMMISSION
 NOV 14 1961
 CONSERVATION DIVISION
 Wichita, Kansas

STATE OF KANSAS)
) SS:
 COUNTY OF SEDGWICK)

I, D. L. Hellar, do hereby certify that the above and foregoing is a true and correct copy of the log of the COLVIN #1 located in the NE SE SE of Section 22-21S-14W, Stafford County, Kansas as reflected by the files of the Hellar Drilling Company, Inc.

HELLAR DRILLING COMPANY, INC.

BY D. L. Hellar
 D. L. Hellar, President

Subscribed and sworn to before me, a Notary Public, in and for Sedgwick County, Kansas, this 7th day of November, 1961.

Wanda Lou Bruce
 Notary Public

My commission expires March 6, 1965.