

WELL PLUGGING RECORD

Give All Information Completely;  
Make Required Affidavit  
Mail or Deliver Report to:  
Conservation Division  
State Corporation Commission  
211 No. Broadway  
Wichita, Kansas

Stafford County. Sec. 22 Twp. 21S Rge. 14 (E) W (W)

Location as "NE/CNW/SW" or footage from lines NE SW NW

Lease Owner Nadel and Gussman

Lease Name Strobel Well No. 1

Office Address 1714 First Natl Bldg., Tulsa 3, Oklahoma

Character of Well (completed as Oil, Gas or Dry Hole) Dry

Date well completed 5-23 19 58

Application for plugging filed 5-23 19 58

Application for plugging approved 5-23 19 58


Plugging commenced 5-23 19 58

Plugging completed 5-23 19 58

Reason for abandonment of well or producing formation Dry

If a producing well is abandoned, date of last production \_\_\_\_\_ 19\_\_

Was permission obtained from the Conservation Division or its agents before plugging was commenced? Yes

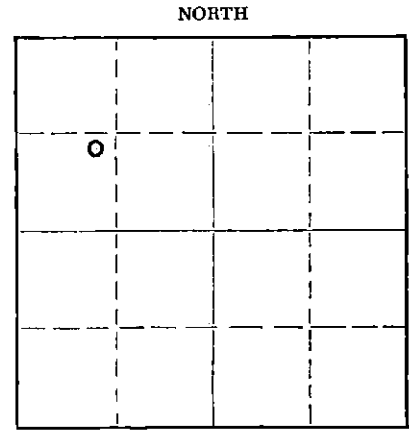

Locate well correctly on above Section Plat

Name of Conservation Agent who supervised plugging of this well Frank Broadfoot

Producing formation \_\_\_\_\_ Depth to top \_\_\_\_\_ Bottom \_\_\_\_\_ Total Depth of Well 3802 Feet

Show depth and thickness of all water, oil and gas formations.

OIL, GAS OR WATER RECORDS

CASING RECORD

| FORMATION | CONTENT | FROM | TO | SIZE   | PUT IN | PULLED OUT |
|-----------|---------|------|----|--------|--------|------------|
|           |         |      |    | 8-5/8" | 266'   | 0          |
|           |         |      |    |        |        |            |
|           |         |      |    |        |        |            |
Describe in detail the manner in which the well was plugged, indicating where the mud fluid was placed and the method or methods used in introducing it into the hole. If cement or other plugs were used, state the character of same and depth placed, from \_\_\_\_\_ feet to \_\_\_\_\_ feet for each plug set.

Filled hole with heavy mud from 3802' to 240'

Set plug with 20 sax cement

Set top plug @ 40' with ten sax cement.

STATE CORPORATION COMMISSION  
WICHITA, KANSAS

JUN 2 1958

CONSERVATION DIVISION  
WICHITA, KANSAS

Name of Plugging Contractor Reserve Drilling Company, Inc.  
Address 625 Union Center, Wichita 2, Kansas

STATE OF Kansas, COUNTY OF Sedgwick, ss.  
L. C. Hay (employee of owner) of the above-described

well, being first duly sworn on oath, says: That I have knowledge of the facts, statements, and matters herein contained and the log of the above-described well as filed and that the same are true and correct. So help me God.

(Signature) L. C. Hay

Wichita, Kansas

(Address)

SUBSCRIBED AND SWORN TO before me this 26th day of May 1958

My commission expires Nov. 3, 1960 Notary Public.

PLUGGING  
FILE SEC. 22 T. 21 R. 14 W  
BOOK PAGE 103 LINE 37

15.185.00485.0000

WELL LOG

Nadel and Guggman

STROBLE No. 1

NE SW NW 22-21-14W

Stafford County, Kansas

Comm: 5-13-58  
Comp: 5-23-58

Casing: 8-5/8" @ 266' w/200 sax

Formations

Depths

|                       |      |
|-----------------------|------|
| Shale, sand and shale | 270  |
| Shale and sand        | 425  |
| Red bed               | 515  |
| Red bed and sand      | 851  |
| Anhydrite             | 875  |
| Shale and shells      | 1630 |
| Lime and shale        | 1840 |
| Lime                  | 1935 |
| Lime and shells       | 2065 |
| Lime and shale        | 2735 |
| Shale and shells      | 3000 |
| Lime and shale        | 3130 |
| Lime                  | 3285 |
| Lime and shale        | 3375 |
| Lime                  | 3755 |
| Lime and sand         | 3773 |
| Lime                  | 3802 |

Geological Tops

|                  |      |
|------------------|------|
| Heebner          | 3289 |
| Brown Lime       | 3409 |
| Lansing          | 3418 |
| Base Kansas City | 3649 |
| Simpson Shale    | 3747 |
| Arbuckle         | 3793 |

RECEIVED  
STATE CORPORATION COMMISSION

JUN 2 1958

CONSERVATION DIVISION  
Wichita, Kansas

STATE OF KANSAS )  
                          ) SS:  
COUNTY OF SEDGWICK )

L. C. Hay, of lawful age, states that the above formations and depths are correct to his best knowledge.

Subscribed and sworn to before me this 26th day of May, 1958.

L. C. Hay  
Notary Public

My commission expires Nov. 3, 1960

|                             |
|-----------------------------|
| PLUGGING                    |
| FILE SEC. 22, T. 21, R. 14W |
| BOOK PAGE 103 LINE 37       |