


WELL PLUGGING RECORD

Give All Information Completely
Make Required Affidavit
Mail or Deliver Report to:
Conservation Division
State Corporation Commission
211 No. Broadway
Wichita, Kansas

Stafford County. Sec. 22 Twp. 21S Rge. 14W (E) (W)
Location as "NE/CNW/SW" or footage from lines NW NW NW
Lease Owner Circle Oil Company
Lease Name Rychlec Well No. 1
Office Address 816 Bitting Bldg., Wichita, Kansas
Character of Well (completed as Oil, Gas or Dry Hole) D & A
Date well completed July 2 19 64
Application for plugging filed July 2 19 64
Application for plugging approved July 2 19 64
Plugging commenced July 2 19 64
Plugging completed July 2 19 64
Reason for abandonment of well or producing formation D & A

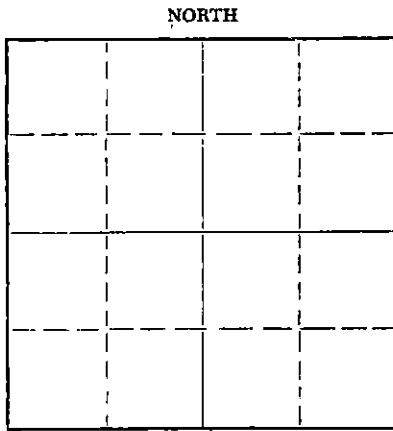

Locate well correctly on above
Section Plat

If a producing well is abandoned, date of last production _____ 19____
Was permission obtained from the Conservation Division or its agents before plugging was commenced? Yes

Name of Conservation Agent who supervised plugging of this well Frank Broadfoot
Producing formation _____ Depth to top _____ Bottom _____ Total Depth of Well 3758 Feet
Show depth and thickness of all water, oil and gas formations.

OIL, GAS OR WATER RECORDS

CASING RECORD

FORMATION	CONTENT	FROM	TO	SIZE	PUT IN	PULLED OUT
				8 5/8"	262.91'	-0-

Describe in detail the manner in which the well was plugged, indicating where the mud fluid was placed and the method or methods used in introducing it into the hole. If cement or other plugs were used, state the character of same and depth placed, from _____ feet to _____ feet for each plug set.

Plugged hole 240' to bottom
of cellar with 90 sx cement.
Set top plug @ 40' w/ 1/2 sx
hulls & 10 sx cement. 5 sx
cement in rathole.

RECEIVED
STATE CORPORATION COMMISSION

JUL 9 1964

CONSERVATION DIVISION
Wichita, Kansas

(If additional description is necessary, use BACK of this sheet)

Name of Plugging Contractor Red Tiger Drilling Company
Address Box 173--Russell, Kansas

STATE OF KANSAS, COUNTY OF SEDGWICK, ss.
Maxine V. Head (employee of owner) of the above-described well, being first duly sworn on oath, says: That I have knowledge of the facts, statements, and matters herein contained and the log of the above-described well as filed and that the same are true and correct. So help me God.

(Signature) Maxine V. Head
1720 Wichita Plaza, Wichita, Kansas
(Address)

SUBSCRIBED AND SWORN TO before me this 6th day of July, 19 64

My commission expires 5-22-66
Jean Hollan Notary Public.

DRILLERS LOG

No. 1 Rychlec

CASING RECORD: 8 5/8" @ 262.91⁵ w/250 sx cement
 COMPANY: Circle Oil Company
 CONTRACTOR: Red Tiger Drilling Company
 COMMENCED: June 24, 1964
 COMPLETED: July 2, 1964
 DESCRIPTION: NW NW NW
 22-21S-14W
 Stafford Co., Kansas
 ELEVATION: 1938 DF
 1941 RB
 TOTAL DEPTH: 3758'

<u>FORMATION</u>	<u>FROM</u>	<u>TO</u>	<u>REMARKS</u>
Sand	0	210	
Shale	210	263	
Shale & Shells	263	280	
Sand	280	394	
Shale Shells & Redbed	394	830	
Redbed & Shale	830	852	
Anhydrite	852	882	
Redbed & Shale	882	1275	
Shale & Shells	1275	1755	
Shale & Lime	1755	2105	
Shale & Shells	2105	2335	
Shale	2335	2610	
Shale & Lime	2610	3290	
Lime	3290	3620	
Lime & Chert	3620	3701	
Lime & Shale	3701	3738	
Lime	3738	3758	

RECEIVED
 STATE CORPORATION COMMISSION
 JUL 9 1964
 CONSERVATION DIVISION
 Wichita, Kansas

I certify that this is a true and correct copy of the above log to the best of my knowledge.

RED TIGER DRILLING COMPANY

Maxine V. Head
 Maxine V. Head

Subscribed and sworn to before me this 6th day of July, 1964.

Edward Hollard
 Notary Public

My Commission Expires:

5-22-66