


STATE OF KANSAS
STATE CORPORATION COMMISSION

WELL PLUGGING RECORD

Give All Information Completely
Make Required Affidavit
Mail or Deliver Report to
Conservation Division
State Corporation Comm.
245 North Water
Wichita, KS 67202

Stafford County, Sec. 22 Twp. 21S Rge. 14W E/W
Location as "NE/CNW $\frac{1}{4}$ SW $\frac{1}{4}$ " or footage from lines
SW SE NE

Lease Owner Icer Addis
Lease Name Strobel Well No. 1
Office Address 5307 E. Central, Wichita, KS 67208
Character of Well (Completed as Oil, Gas or Dry Hole)
dry hole

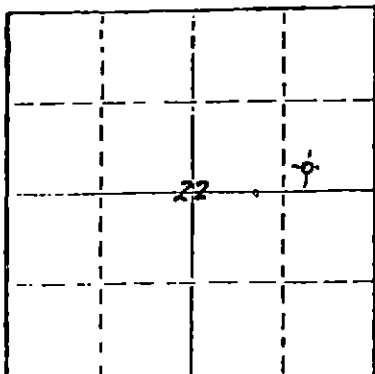

Locate well correctly on above
Section Plot

Date Well completed March 11 1980
Application for plugging filed March 11 1980
Application for plugging approved March 11 1980
Plugging commenced March 11 1980
Plugging completed March 11 1980
Reason for abandonment of well or producing formation

If a producing well is abandoned, date of last production
19

Was permission obtained from the Conservation Division or
its agents before plugging was commenced? yes

Name of Conservation Agent who supervised plugging of this well Duane Rankin, Great Bend, KS
Producing formation Depth to top Bottom Total Depth of Well 3789
Show depth and thickness of all water, oil and gas formations.

OIL, GAS OR WATER RECORDS

CASING RECORD

FORMATION	CONTENT	FROM	TO	SIZE	PUT IN	PULLED OUT

Describe in detail the manner in which the well was plugged, indicating where the mud fluid
was placed and the method or methods used in introducing it into the hold. If cement or other
plugs were used, state the character of same and depth placed, from feet to
feet for each plug set.

Plugged as follows:

Filled hole w/mud, pumped 50 sx 50/50 pozmix, 4% gel thru open end d.p.
@ 480'; mud to 270'; pumped 25 sx thru open end d.p., mud to 40'; 1/2 sx
hulls & wood plug for solid bridge; pumped 10 sx to base of cellar;
5 sx in rathole; compled at 6:30 p.m. 3-11-80 by Halliburton.

Witnessed: Duane Rankin, State Plugger, Great Bend, Kansas
Gary Bagby, Sterling, Kansas.

3-14-80

(If additional description is necessary, use BACK of this sheet)

Name of Plugging Contractor HUSKY DRILLING CO., INC.

RECEIVED
STATE CORPORATION COMMISSION
MAR 14 1980

STATE OF KANSAS COUNTY OF SEDGWICK
Jon T. Williams, Jr. (employee of owner or owner or operator)
of the above-described well, being first duly sworn on oath, says: That I have knowledge of
the facts, statements, and matters herein contained and the log of the above-described well
as filed and that the same are true and correct. So help me God.


(Signature)

200 E. First, Suite 500, Wichita, KS 67202
(Address)

SUBSCRIBED AND SWORN TO before me this 13th day of March, 1980

Geraldine Stewart
Geraldine Stewart Notary Public.

My commission expires January 12, 1981

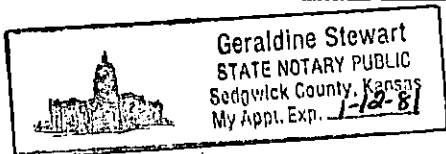



200 E. First, Suite 500
~~800 Biking Blvd~~
Wichita, Kansas 67202
Phone 316 - 263-7904
Mobile Phone 316 - 793-7859 Unit 7070

March 13, 1980

WELL LOG- - - - - Strobel No. 1
Location: SW SE NE of Sec. 22-21S-14W, Ness Co., Kansas

OWNER: Icer Addis
ROTARY CONTRACTOR: Husky Drilling Co., Inc.

COMMENCED: March 6, 1980
COMPLETED: March 11, 1980

Rotary Total Depth: 3789'

LOG

CASING RECORD

0 - 198 Sand & gravel
198 - 280 Shale
280 - 325 Sand
325 - 850 Red Bed & shale
850 - 873 Anhydrite
873 - 1990 Shale & shells
1990 - 3462 Shale & lime
3462 - 3700 Lime
3700 - 3782 Lime & Shale
3782 - 3789 Lime

Ran 7 jts., 8-5/8", 28#, 8V, Rge 2&3, used csg., tallied 269', set @ 275 KB w/225 sx 60/40 pozmix 2% gel, 3% cc, circulated - plug down @ 2:30 p.m. by Halliburton 3-6-80.

Plugged & Abandoned 3-11-80.

RECEIVED
STATE CORPORATION COMMISSION
MAR 14 1980
CONSERVATION DIVISION
Wichita, Kansas