


STATE OF KANSAS
STATE CORPORATION COMMISSION

WELL PLUGGING RECORD

Give All Information Completely
Make Required Affidavit
Mail or Deliver Report to
Conservation Division
State Corporation Comm.
245 North Water
Wichita, KS 67202

Stafford County, Sec. 22 Twp. 21S Rge. 14W E/W
Location as "NE/CNW $\frac{1}{4}$ SW $\frac{1}{4}$ " or footage from lines
SW NE NE

Lease Owner Tarpin Resources
Lease Name Strobel "B" #1 Well No. "B" #1
Office Address 4665 1st International Bldg, Dallas, Tex. 75270
Character of Well (Completed as Oil, Gas or Dry Hole)
Dry Hole

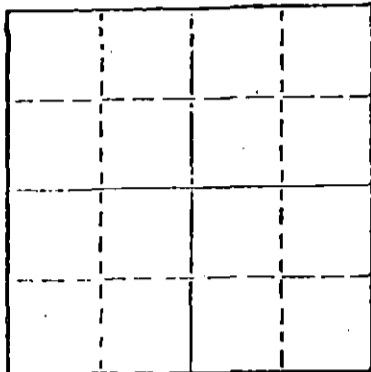

Locate well correctly on above
Section Plat

Date Well completed October 11, 1981
Application for plugging filed October 11, 1981
Application for plugging approved October 11, 1981
Plugging commenced 9:45 PM, October 11, 1981
Plugging completed 11:00 PM, October 11, 1981
Reason for abandonment of well or producing formation
Dry Hole

If a producing well is abandoned, date of last production
19

Was permission obtained from the Conservation Division or
its agents before plugging was commenced? Yes

Name of Conservation Agent who supervised plugging of this well J. H. Metz
Producing formation Depth to top Bottom Total Depth of Well 3833'
Show depth and thickness of all water, oil and gas formations.

OIL, GAS OR WATER RECORDS

CASING RECORD

FORMATION	CONTENT	FROM	TO	SIZE	PUT IN	PULLED OUT
				8 5/8"	291'	None

Describe in detail the manner in which the well was plugged, indicating where the mud fluid
was placed and the method or methods used in introducing it into the hold. If cement or other
plugs were used, state the character of same and depth placed, from feet to
feet for each plug set.

Filled hole with heavy mud. Heavy mud to 690' with 60 sacks
50/50 Pozmix with 2% gel and 3% cc at 690' through open
ended drill pipe. Heavy mud to 290' with 40 sacks through
open ended drill pipe. Heavy mud to 40' with 1/2 sack hulls
and Howco plug with solid bridge at 40'. 10 sacks in rathole.

RECEIVED 10-14-81
STATE CORPORATION COMMISSION

(If additional description is necessary, use BACK of this sheet)
Name of Plugging Contractor Sterling Drilling Company, P. O. Box 129, Sterling, Kansas 67579
Wichita, Kansas

STATE OF KANSAS COUNTY OF RICE, ss.
F. A. Wuellner (employee of owner) or (owner or operator)

of the above-described well, being first duly sworn on oath, says: That I have knowledge of
the facts, statements, and matters herein contained and the log of the above-described well
as filed and that the same are true and correct. So help me God.

STERLING DRILLING COMPANY
(Signature) F. A. Wuellner
F. A. Wuellner, Secretary
P. O. Box 129, Sterling, Kansas 67579
(Address)

SUBSCRIBED AND SWORN TO before me this 12th day of October, 19 81.



My commission expires

Agnes D. Wurst
Agnes D. Wurst, Notary Public.

STERLING DRILLING COMPANY
P. O. Box 129
Sterling, Kansas 67579

WELL LOG - - - - - STROBEL "B" #1
Located: SW NE NE, Section 22-21S-14W, Stafford County, Kansas

OWNER: Tarpin Resources
ROTARY DRILLING CONTRACTOR: Sterling Drilling Company

COMMENCED: October 5, 1981
COMPLETED: October 11, 1981

TOTAL DEPTH: 3833'

<u>LOG</u>	
0 - 120	Sand
120 - 200	Shale
200 - 295	Clay and Shale
295 - 500	Sand and Shale
500 - 1415	Shale
1415 - 1780	Shale and Lime Stringers
1780 - 3250	Lime and Shale
3250 - 3400	Lime
3400 - 3500	Lime and Shale
3500 - 3700	Lime
3700 - 3775	Lime and Shale
3775 - 3833	Arbuckle

CASING RECORD
 Ran 7 joints 8 5/8", 20# new casing.
 280.55' pipe set at 291' K.B. Cemented
 with 250 sacks 60/40 Pozmix with 2% gel and
 3% cc. Plug down at 6:00 PM, 10-5-81.

Plugged.

RECEIVED
 STATE CORPORATION COMMISSION
 OCT 14 1981
 CONSERVATION DIVISION
 Wichita, Kansas

Deviation Surveys: 1° at 1780'
2° at 3833'