


STATE OF KANSAS
STATE CORPORATION COMMISSION

WELL PLUGGING RECORD

Give All Information Completely
Make Required Affidavit
Mail or Deliver Report to:
Conservation Division
State Corporation Commission
800 Bitting Building
Wichita, Kansas

Stafford County, Sec. 20 Twp. 21 Rge. 14 (E) (W)
Location as "NE/CNW $\frac{1}{4}$ SW $\frac{1}{4}$ " or footage from lines NE SE SW
Lease Owner Petroleum, Inc.
Lease Name Russell 'B' Well No. 1
Office Address 100 Derby Bldg., Wichita, Kansas
Character of Well (completed as Oil, Gas or Dry Hole) Dry Hole
Date well completed October 13, 1951
Application for plugging filed October 13, 1951
Application for plugging approved October 13, 1951
Plugging commenced October 13, 1951
Plugging completed October 14, 1951
Reason for abandonment of well or producing formation Dry Hole

NORTH

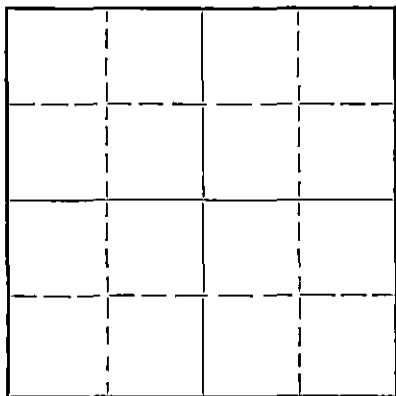

Locate well correctly on above
Section Plat

If a producing well is abandoned, date of last production 19
Was permission obtained from the Conservation Division or its agents before plugging was commenced? Yes

Name of Conservation Agent who supervised plugging of this well Mr. Charley Stough
Producing formation Depth to top Bottom Total Depth of Well 3821 Feet
Show depth and thickness of all water, oil and gas formations.

OIL, GAS OR WATER RECORDS

CASING RECORD

Formation	Content	From	To	Size	Put In	Pulled Out
				8 5/8 ⁱⁿ	255'	None

Describe in detail the manner in which the well was plugged, indicating where the mud fluid was placed and the method or methods used in introducing it into the hole. If cement or other plugs were used, state the character of same and depth placed, from feet to feet for each plug set.

Pits were jetted. Heavy mud was mixed and pumped into hole. Wooden plug was placed at 255 and 100 sacks cement were mixed and pumped in on top of plug by Globe process.

RECEIVED
STATE CORPORATION COMMISSION
OCT 17 1951
CONSERVATION DIVISION
Wichita, Kansas

(If additional description is necessary, use BACK of this sheet)

Correspondence regarding this well should be addressed to Petroleum, Inc.
Address 100 Derby Bldg., Wichita, Kansas

STATE OF KANSAS, COUNTY OF SEDGWICK, ss.
Eric H. Jager (employee of owner) of the above-described well, being first duly sworn on oath, says: That I have knowledge of the facts, statements, and matters herein contained and the log of the above-described well as filed and that the same are true and correct. So help me God.

(Signature) Eric H. Jager
100 Derby Bldg., Wichita, Kansas (Address)

SUBSCRIBED AND SWORN TO before me this 16th day of October, 1951.
Charlotte Heidman
Notary Public.

My commission expires October 13, 1954

PLUGGING
FILE SEC 20 Twp 21 Rge 14
BOOK PAGE 17 LINE 10

WELL LOG RUSSELL 'B' NO.1

Petroleum, Inc., Lease Owner

Section: 20, Twp. 21S, Rge. 14W

Garvey Oil, Contractor

Location: NE SE SW

Drilling Commenced: October 2, 1951

County: Stafford

Drilling Completed: October 13, 1951

Production: D & A

Casing Record: 255' of 8 5/8" w/175 sax

Elevation: 1946 R.B.

Rotary Total Depth: 3821'

All figures below indicate bottom of formation:

		<u>Tops:</u>	
20	Surface Soil		
240	Sand		
255	Shale	3290	(-1344) Heebner
275	Shale & Shells	3407	(-1461) Brown Lime
310	Red Bed	3418	(-1472) Lansing
400	Sand	3680	(-1734) Viola
870	Red Bed	3727	(-1781) Simpson
1200	Shale & Shells	3781	(-1835) Arbuckle
1350	Salt & Shale		
1890	Shale & Shells		
2610	Lime & Shale		
2790	Shale & Shells		
3100	Lime & Shale		
3165	Lime		
3210	Lime & Shale		
3325	Lime		
3405	Lime & Shale		
3694	Lime		
3734	Conglomerate		
3777	Shale		
3821	Lime		

DST#1, 3534-47, open 45", rec. 25' mud, 1160# BHP.

3821' R.T.D.

I hereby certify that this is a true and correct log of the above mentioned well.

PETROLEUM, INC.

By Eric H. Jager
Eric H. Jager

STATE OF KANSAS)
COUNTY OF SEDGWICK)

RECEIVED
STATE CORPORATION COMMISSION
OCT 17 1951
CONSERVATION DIVISION
Wichita, Kansas

Subscribed to and sworn to before me, a Notary Public, in said county and state this 10th day of October, 1951.

PLUGGING

FILE SEC 20 T 21 R 14 W
BOOK PAGE 47 LINE 10

Charlotta Weidman
Notary Public

My commission expires: October 13, 1954