


STATE OF KANSAS
STATE CORPORATION COMMISSION

Form CP-4

Give All Information Completely
Make Required Affidavit
Mail or Deliver Report to:
Conservation Division
State Corporation Commission
212 No. Market
Wichita, Kansas 67202

WELL PLUGGING RECORD

NORTH

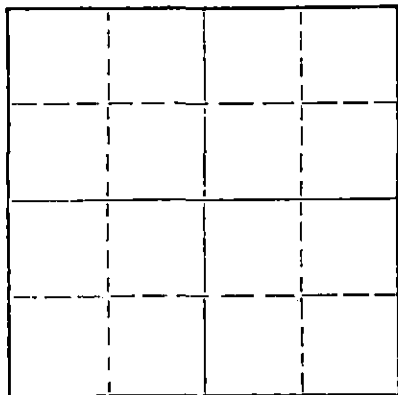

Locate well correctly on above Section Plot

Hodgeman County. Sec. 30 Twp. 21S Rge. (E) 21(W)
Location as "NE/CNWxSWx" or footage from lines C/NW NW
Lease Owner Francis Oil & Gas, Inc.
Lease Name Stueckemann "A" Well No. 1
Office Address 4120 East 51st Street, Tulsa, Oklahoma 74135
Character of Well (completed as Oil, Gas or Dry Hole) Dry Hole
Date well completed April 8 19 71
Application for plugging filed April 8 19 71
Application for plugging approved April 8 19 71
Plugging commenced April 8 19 71
Plugging completed April 8 19 71
Reason for abandonment of well or producing formation DRY HOLE

If a producing well is abandoned, date of last production _____ 19 ____
Was permission obtained from the Conservation Division or its agents before plugging was commenced? Yes

Name of Conservation Agent who supervised plugging of this well Edgar J. Eves, Sublette, Kansas
Producing formation _____ Depth to top _____ Bottom _____ Total Depth of Well 4507 Feet
Show depth and thickness of all water, oil and gas formations.

OIL, GAS OR WATER RECORDS

CASING RECORD

FORMATION	CONTENT	FROM	TO	SIZE	PUT IN	PULLED OUT
	8-5/8"	0'	255.14'			

Describe in detail the manner in which the well was plugged, indicating where the mud fluid was placed and the method or methods used in introducing it into the hole. If cement or other plugs were used, state the character of same and depth placed, from _____ feet to _____ feet for each plug set.

Plugged hole as follows: Plugged at 850' with 80 sacks of common cement; plugged at 200' with 30 sacks of common cement; plugged at 45' with 15 sacks of common cement. Plug down at 10:15 P. M. April 8, 1971.

RECEIVED
STATE CORPORATION COMMISSION
APR 14 1971
CONSERVATION DIVISION
Wichita, Kansas

(If additional description is necessary, use BACK of this sheet)
Name of Plugging Contractor Strata Drilling, Inc.
Address P. O. Box 355, Great Bend, Kansas 67530

STATE OF KANSAS, COUNTY OF BARTON, ss.
Charles W. Steincamp (employee of owner) or (~~owner~~) of the above-described well, being first duly sworn on oath, says: That I have knowledge of the facts, statements, and matters herein contained and the log of the above-described well as filed and that the same are true and correct. So help me God.

(Signature) Charles W. Steincamp
Charles W. Steincamp, President
P. O. Box 355, Great Bend, Kansas 67530
(Address)

SUBSCRIBED AND SWORN TO before me this 9th day of April, 19 71

My commission expires December 14, 1973

Elaine H. Taylor
Elaine H. Taylor
Notary Public.

D R I L L E R S L O G

#1 Stueckemann "A"

CASING RECORD:
249.14' of new 8-5/8"
surface casing.

COMPANY: Francis Oil & Gas, Inc..

DESCRIPTION: C/NW NW
Section 30-21S-21W
Hodgeman County, Kansas

TOTAL DEPTH:
4507'

COMMENCED: March 31, 1971

ELEVATION: 2251' K. B.

COMPLETED: April 8, 1971

D. & A.

<u>FORMATION</u>	<u>FROM</u>	<u>TO</u>	<u>REMARKS</u>
Clay & Rock	0	55	Ran 249.14' of new 8-5/8" surface casing; set and cemented at 255.14' with 160 sacks of regular cement, 2% gel and 3% C. C. Plug down at 6:00 P. M. March 31, 1971.
Shale & Red Bed	55	305	
Shale & Clay	305	557	
Shale	557	575	
Red Bed & Sand Streaks	575	779	
#1 Anhydrite	779	789	
Red Bed	789	866	
Sand	866	1050	
Red Bed, Shale & Shells	1050	1438	
#2 Anhydrite	1438	1450	
Red Bed & Shale	1450	1740	
Shale	1740	2230	
Lime & Shale	2230	4000	
Lime	4000	4265	
Lime & Shale	4265	4342	
Lime	4342	4439	
Cherty Lime & Shale	4439	4474	
Chert	4474	4504	
Lime	4504	4507	

RECEIVED
STATE CORPORATION COMMISSION
APR 14 1971
CONSERVATION DIVISION
Wichita, Kansas

D. & A.

ROTARY TOTAL DEPTH: 4507'

Plugged hole as follows: Plugged at 850' with 80 sacks of common cement; plugged at 200' with 30 sacks of common cement; plugged at 45' with 15 sacks of common cement. Plug down at 10:15 P. M. April 8, 1971.

STATE OF KANSAS)
) SS.
COUNTY OF BARTON)

I certify that this is a true and correct copy of the above log to the best of my knowledge.

STRATA DRILLING, INC.

Charles W. Steincamp
Charles W. Steincamp, President

Subscribed and sworn to before me this 9th day of April, 1971.

My Commission Expires:
December 14, 1973

Elaine H. Taylor
Elaine H. Taylor, Notary Public