


STATE OF KANSAS  
STATE CORPORATION COMMISSION

Form CP-4

Give All Information Completely  
Make Required Affidavit.  
Mail or Deliver Report to:  
Conservation Division  
State Corporation Commission  
211 No. Broadway  
Wichita, Kansas

WELL PLUGGING RECORD

Kearny County. Sec. 35 Twp. 21S Rge. 38W (E) (W)  
Location as "NE/CNW/SW" or footage from lines NW of SW Sec. 35  
Lease Owner TeSoro Petroleum Corporation  
Lease Name Plummer A #1 Well No. \_\_\_\_\_  
Office Address P.O. Box 3305, Bartlesville, Okla. 74003  
Character of Well (completed as Oil, Gas or Dry Hole) Dry  
Date well completed Feb. 26, 1972 19 \_\_\_\_  
Application for plugging filed July 10, 1972 19 \_\_\_\_  
Application for plugging approved July 19, 1972 19 \_\_\_\_  
Plugging commenced 8/1/ 19 72  
Plugging completed 8/4/ 19 72  
Reason for abandonment of well or producing formation 100% water productive

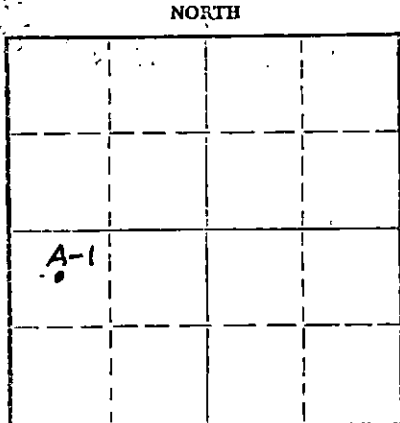

Locate well correctly on above  
Section Plat

If a producing well is abandoned, date of last production Not Applicable 19 \_\_\_\_  
Was permission obtained from the Conservation Division or its agents before plugging was commenced? yes

Name of Conservation Agent who supervised plugging of this well Mr. E. Evey (?) (see copy attached)  
Producing formation DRY Depth to top \_\_\_\_\_ Bottom \_\_\_\_\_ Total Depth of Well 5354 Feet  
Show depth and thickness of all water, oil and gas formations.

OIL, GAS OR WATER RECORDS

CASING RECORD

FORMATION	CONTENT	FROM	TO	SIZE	PUT IN	PULLED OUT
NONE						

Describe in detail the manner in which the well was plugged, indicating where the mud fluid was placed and the method or methods used in introducing it into the hole. If cement or other plugs were used, state the character of same and depth placed, from \_\_\_\_\_ feet to \_\_\_\_\_ feet for each plug set.

20 sks. cement and 1 sk. hulls to plug perms. Stop plug at 4,900'  
Pump 35 sks. cement at 900' to 800'.  
Put 15 sks. cement at 45' to 0'.

RECEIVED  
STATE CORPORATION COMMISSION

AUG 24 1972

CONSERVATION DIVISION  
Wichita, Kansas

(If additional description is necessary, use BACK of this sheet)

Name of Plugging Contractor SARGENTS CASING PULLING SERVICE  
Address Box 506, Liberal, Kansas 67901

STATE OF KANSAS, COUNTY OF SEWARD, ss.  
CHESTER A. NORDLING (employee of owner) or (~~owner or operator~~) of the above-described well, being first duly sworn on oath, says: That I have knowledge of the facts, statements, and matters herein contained and the log of the above-described well as filed and that the same are true and correct. So help me, God. SARGENTS CASING PULLING SERVICE

(Signature) Chester A. Nordling Partner

Box 506, Liberal, Kansas 67901  
(Address)

Subscribed and sworn to before me this 10th day of August, 19 72

My Commission Expires Dec. 29, 1973.

Virginia M. Avey  
Notary Public.  
Virginia M. Avey

