


WELL PLUGGING RECORD

Give All Information Completely
Make Required Affidavit
Mail or Deliver Report to:
Conservation Division
State Corporation Commission
211 No. Broadway
Wichita, Kansas

Kearney County. Sec. 35 Twp 21S Rge. (E) 38 (W)
Location as "NE/CNW/SW" or footage from lines C NW/4 SW/4
Lease Owner Herman George Kaiser
Lease Name Plummer Well No. 1
Office Address 909 Palace Building, Tulsa, Oklahoma
Character of Well (completed as Oil, Gas or Dry Hole) Dry Hole
Date well completed 13 October 19 60
Application for plugging filed Verbally 13 October 19 60
Application for plugging approved " 13 October 19 60
Plugging commenced 13 October 19 60
Plugging completed 13 October 19 60
Reason for abandonment of well or producing formation Dry Hole

NORTH

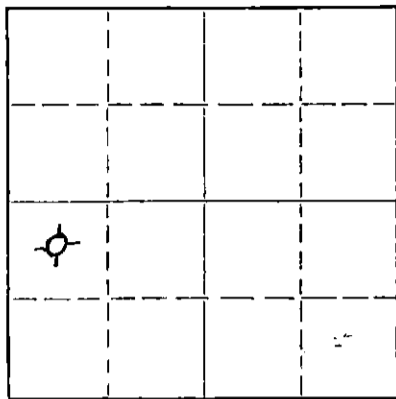

Locate well correctly on above
Section Plat

If a producing well is abandoned, date of last production None 19
Was permission obtained from the Conservation Division or its agents before plugging was commenced? Yes

Name of Conservation Agent who supervised plugging of this well Frank Broadfoot, 222 South Main St. John, Kansas 5150
Producing formation None Depth to top Bottom Total Depth of Well 5150 Feet
Show depth and thickness of all water, oil and gas formations.

OIL, GAS OR WATER RECORDS

CASING RECORD

FORMATION	CONTENT	FROM	TO	SIZE	PUT IN	PULLED OUT
Surface	Waters	-	-	8-5/8	1103	None

Describe in detail the manner in which the well was plugged, indicating where the mud fluid was placed and the method or methods used in introducing it into the hole. If cement or other plugs were used, state the character of same and depth placed, from feet to feet for each plug set.

Jetted pits and mixed heavy rotary mud and well cuttings and placed through drill pipe to 1,050 feet from top.

Set a wooden plug with 1/2 sack of hulls placed 25 sacks cement on top through drill pipe.

Placed heavy mud through drill pipe to 45 feet.

Set a wooden plug with 1/2 sack of hulls and placed 10 sacks of cement on top through drill pipe.

OCT 20 1960
10-20-1960
CONSERVATION DIVISION
Wichita, Kansas

(If additional description is necessary, use BACK of this sheet)
Name of Plugging Contractor Stickle Drilling Company.
Address 1100 Bitting Building, Wichita 2, Kansas

STATE OF KANSAS, COUNTY OF SEDGWICK, ss.
R. B. PARRIOTT (employee of owner) or (owner or operator) of the above-described well, being first duly sworn on oath, says: That I have knowledge of the facts, statements, and matters herein contained and the log of the above-described well as filed and that the same are true and correct. So help me God.

(Signature) R. B. Parriott
1100 Bitting Bldg., Wichita 2, Kansas
(Address)

SUBSCRIBED AND SWORN TO before me this 19th day of October, 1960

My commission expires 17 February 1962

Charley V. Shank
Charley V. Shank, Notary Public.



Herman George Kaiser, Oil Producer
905 Palace Building
Tulsa 3, Oklahoma

Tulsa, Oklahoma
October 17, 1960

Contractor: Stickle Drilling Company
Date Commenced: September 21, 1960
Date Completed: October 13, 1960

Plummer "A" No. 1,
Ctr. NW SW Sec. 35-21S-38W
Kearny County, Kansas

DRILLER'S LOG


Depth Figures Indicate Base of Formation:

Sand	160
Shale	400
Surface sand and shale	900
Shale	1020
Red Bed	1104
Red Bed and shale	1600
Red Bed and Gypsum	2070
Red Bed	2180
Anhydrite	2193
Red Bed	2285
Red Bed and shale	2560
Shale and shells	2790
Lime and shales	2945
Shale and lime	3070
Lime and shale	3175
Lime	3232
Lime and shale	3330
Lime	4021
Limestone	4037
Lime	4714
Lime, hard	4745
Broken lime and shale	4756
Lime and shale	4806
Lime and blue shale	4845
Lime	5069
Lime and chert	5086
Lime	5150 TD

STATE OF KANSAS
STATE GEOLOGICAL SURVEY

OCT 20 1960
CONSERVATION DIVISION
Wichita, Kansas

I, Fred E. Stickle, hereby certify the above to be a true and complete Driller's Log of Herman George Kaiser's Plummer "A" Well No. 1, Center of Northwest Quarter (NW/4) of the Southwest Quarter (SW/4) of Section 35-21S-38W., Kearny County, Kansas.


Fred E. Stickle


Notary Public

My commission expires March 25, 1964.