


Give All Information Completely
Make Required Affidavit
Mail or Deliver Report to:
Conservation Division
State Corporation Commission
212 No. Market
Wichita, Kansas

WELL PLUGGING RECORD

Kearny County, Sec. 27 Twp. 21S Rge. 38W (E) (W)

Location as "NE/CNW/SW" or footage from lines C NW NW
Lease Owner Clary Petroleum Corporation
Lease Name Blake Well No. 1-27
Office Address 310 Kermac Building
Character of Well (completed as Oil, Gas or Dry Hole) dry
Date well completed October 27 19 68
Application for plugging filed yes 19
Application for plugging approved yes 19
Plugging commenced October 27 19 68
Plugging completed October 27 19 68
Reason for abandonment of well or producing formation dry

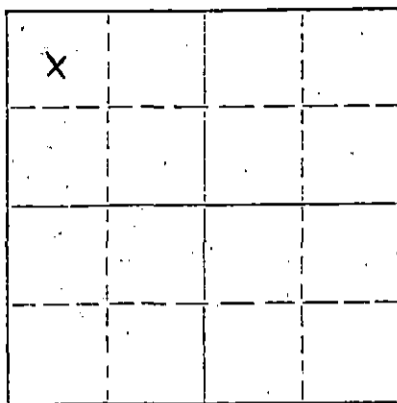

Locate well correctly on above Section Plat

If a producing well is abandoned, date of last production _____ 19 ____
Was permission obtained from the Conservation Division or its agents before plugging was commenced? _____

Name of Conservation Agent who supervised plugging of this well J. Lewis Brock
Producing formation None Depth to top _____ Bottom _____ Total Depth of Well 5400 Feet
Show depth and thickness of all water, oil and gas formations.

OIL, GAS OR WATER RECORDS

CASING RECORD

FORMATION	CONTENT	FROM	TO	SIZE	PUT IN	PULLED OUT
None	s			8-5/8	1252	none

Describe in detail the manner in which the well was plugged, indicating where the mud fluid was placed and the method or methods used in introducing it into the hole. If cement or other plugs were used, state the character of same and depth placed, from _____ feet to _____ feet for each plug set.

35 sack plug from 1,000 - 1,200'.
15 sack plug from surface to 40'.

RECEIVED
NOV 12 1968
STATE CORPORATION COMMISSION
CONSERVATION DIVISION
Wichita, Kansas

(If additional description is necessary, use BACK of this sheet)
Name of Plugging Contractor Rine Drilling Company, 300 W. Douglas, Wichita, Kansas
Address _____

STATE OF Kansas, COUNTY OF Kearny, ss.

(employee of owner) or (owner or operator) of the above-described well, being first duly sworn on oath, says: That I have knowledge of the facts, statements, and matters herein contained and the log of the above-described well as filed and that the same are true and correct. So help me God.

(Signature) Jack K. Richardson
Jack K. Richardson, Sr. Exploitation Engineer
310 Kermac Building, Oklahoma City, Oklahoma
(Address) _____ 73102

SUBSCRIBED AND SWORN to before me this 8th day of November, 1968

Charles J. Taylor
Notary Public.

My commission expires October 16, 1970