

STATE OF KANSAS  
STATE CORPORATION COMMISSION


WELL PLUGGING RECORD

Give All Information Completely  
Make Required Affidavit  
Mail or Deliver Report to  
Conservation Division  
State Corporation Comm.  
245 North Water  
Wichita, KS 67202

Hamilton County. Sec. 32 Twp. 21S Rge. 39 NE/W  
Location as "NE/CNW $\frac{1}{4}$ SW $\frac{1}{4}$ " or footage from lines \_\_\_\_\_

C/SE/NW  
Lease Owner Petromark Exploration, Inc.  
Lease Name Tina Well No. 1

Office Address 4606 E. 67th., Tulsa, Okla. 74177  
Character of Well (Completed as Oil, Gas or Dry Hole) \_\_\_\_\_

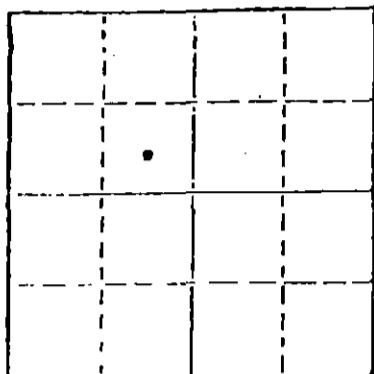

Locate well correctly on above  
Section Plot

Gas  
Date Well completed December 11 1981  
Application for plugging filed March 11 1982  
Application for plugging approved March 15 1982  
Plugging commenced June 2 1982  
Plugging completed June 2 1982  
Reason for abandonment of well or producing formation \_\_\_\_\_

Dry Hole  
If a producing well is abandoned, date of last production  
None 19  

Was permission obtained from the Conservation Division or  
its agents before plugging was commenced? Yes

Name of Conservation Agent who supervised plugging of this well Clarence Thomas  
Producing formation U Winfield Depth to top 2770 Bottom 2778 Total Depth of Well 2825  
Show depth and thickness of all water, oil and gas formations.

OIL, GAS OR WATER RECORDS

CASING RECORD

FORMATION	CONTENT	FROM	TO	SIZE	PUT IN	PULLED OUT
Blue Shale	Shale	Gr	369'	8-5/8"	369'	--
				4-1/2"	2823'	--

Describe in detail the manner in which the well was plugged, indicating where the mud fluid was placed and the method or methods used in introducing it into the hold. If cement or other plugs were used, state the character of same and depth placed, from \_\_\_\_\_ feet to \_\_\_\_\_ feet for each plug set.

Plugged to abandon w/ 110 sx, 50/50 (Class H/Poz A), 6% gell as follows; 45 sx cement followed by 5 wiper rubber plug & disp. w/ gelled water, followed by 35 sx cement and 1 sx of cotton seed hulls; filled 8-5/8" x 4 1/4" csg. annulus w/ 30 sx cement; cut-off csg. 3' below Gr & capped; job complete @ 12:00 p.m., 6/2/82.

(If additional description is necessary, use BACK of this sheet)

Name of Plugging Contractor Halliburton Services

STATE OF Kansas COUNTY OF Seward, ss.  
Reed Wacker (employee of owner) or (owner or operator)


of the above-described well, being first duly sworn on oath, says: That I have knowledge of the facts, statements, and matters herein contained and the log of the above-described well as filed and that the same are true and correct. So help me God.

(Signature) Reed Wacker  
P.O. Box 6; Liberal, KS 67901  
(Address)

SUBSCRIBED AND SWORN TO before me this 8th day of June, 19 82

A. J. Parnell  
Notary Public.

My commission expires

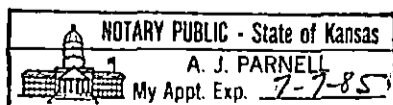

RECEIVED  
STATE CORPORATION COMMISSION

CONSERVATION DIVISION  
Wichita, Kansas