


Give All Information Completely
Make Required Affidavit
Mail or Deliver Report to:
Conservation Division
State Corporation Commission
211 No. Broadway
Wichita, Kansas

WELL PLUGGING RECORD

NORTH

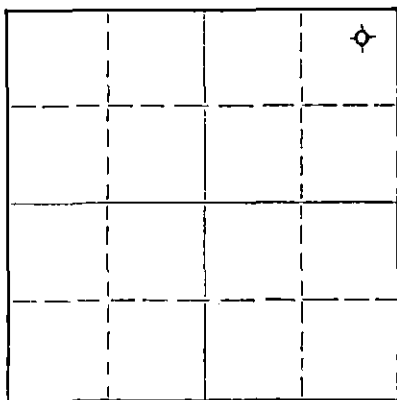

Locate well correctly on above
Section Plat

MCPHERSON

County. Sec. 21 Twp. 21 Rge. 1 (W)

Location as "NE/CNW/SW" or footage from lines NE/6 NE/4 NE/4

Lease Owner PRAIRIE OIL & GAS CO., INC.

Lease Name WENGER Well No. 1

Office Address 308 PETROLEUM BUILDING, WICHITA 2, KANSAS

Character of Well (completed as Oil, Gas or Dry Hole) DRY HOLE

Date well completed NOVEMBER 9 1956

Application for plugging filed NOVEMBER 9 1956

Application for plugging approved NOVEMBER 9 1956

Plugging commenced NOVEMBER 9 1956

Plugging completed NOVEMBER 9 1956

Reason for abandonment of well or producing formation

If a producing well is abandoned, date of last production 19

Was permission obtained from the Conservation Division or its agents before plugging was commenced? YES

Name of Conservation Agent who supervised plugging of this well MR. RUEL DURKEE, Box 597 MCPHERSON, KS.

Producing formation Depth to top Bottom Total Depth of Well 3386 Feet

Show depth and thickness of all water, oil and gas formations.

OIL, GAS OR WATER RECORDS

CASING RECORD

FORMATION	CONTENT	FROM	TO	SIZE	PUT IN	PULLED OUT
				8-5/8 OD	215'	NONE

Describe in detail the manner in which the well was plugged, indicating where the mud fluid was placed and the method or methods used in introducing it into the hole. If cement or other plugs were used, state the character of same and depth placed, from feet to feet for each plug set.

HOLE FILLED WITH MUD FROM 3386' TO 210';
THEN 15 SACKS CEMENT;
THEN MUD TO 15';
CEMENT FROM 15' TO 0;
STEEL PLATE WELDED ON TOP OF SURFACE PIPE

(If additional description is necessary, use BACK of this sheet)

Name of Plugging Contractor PRAIRIE OIL & GAS CO.

Address WICHITA, KANSAS

STATE OF KANSAS, COUNTY OF SEDGWICK, ss.

JERRY E. SHAWVER (XXXXXXXXXX) or (owner or operator) of the above-described

well, being first duly sworn on oath, says: That I have knowledge of the facts, statements, and matters herein contained and the log of the above-described well as filed and that the same are true and correct. So help me God.

(Signature) Jerry E. Shawver


308 PETROLEUM BLDG., WICHITA 2, KAN

(Address) 56

Subscribed and sworn to before me this 19TH day of NOVEMBER, 1956

My commission expires MARCH 23, 1960

DONNA M. MATZKE Notary Public.

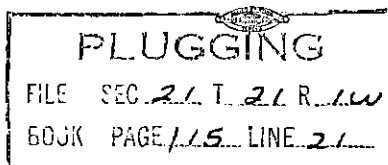

NOV 20 1956
CONSERVATION DIVISION
Wichita, Kansas
11-20-56

PRAIRIE OIL & GAS COMPANY, INC.
308 PETROLEUM BUILDING
WICHITA 2, KANSAS

L O G

WENGER NO. 1 NE/4 Sec. 21-21S-1W, McPHERSON COUNTY, KANSAS
LOCATION: 330' FROM NL & 330' FROM EL NE/4

OWNER: PRAIRIE OIL & GAS COMPANY, INC. DRILLING COMMENCED 10/27/56
CONTRACTOR: PRAIRIE OIL & GAS COMPANY, INC. DRILLING COMPLETED 11/9/56

8-5/8" OD 215' CEMENTED W/170 SACKS ELEVATION: 1512' DF
1515' KB

SANDY SHALE	140
SHALE	215
SHALE & SHELLS	2218
SAND	2226
SHALE	2361
K.C. LIME	2627
LIME & SHALE	2964
CHAT	2971
MISS. LIME	3275
SHALE	3374
HUNTON LIME	3386 RTD

TOPS:
K.C. LIME 2361
MISSISSIPPI LIME 2971
HUNTON LIME 3374

D & A

STATE OF KANSAS)

) ss: ACKNOWLEDGMENT FOR INDIVIDUAL PLUGGING
COUNTY OF SEDGWICK)

RECEIVED
STATE CORPORATION COMMISSION
CONSERVATION DIVISION
Wichita, Kansas

BEFORE ME, THE UNDERSIGNED, A NOTARY PUBLIC, WITHIN AND FOR SAID COUNTY AND STATE, ON THIS 19 DAY OF NOVEMBER, 19 56, PERSONALLY APPEARED JERRY E. SHAWVER TO ME PERSONALLY KNOWN TO BE THE IDENTICAL PERSON WHO EXECUTED THE WITHIN AND FOREGOING INSTRUMENT AND ACKNOWLEDGED TO ME THAT HE EXECUTED THE SAME AS HIS FREE AND VOLUNTARY ACT AND DEED FOR THE USES AND PURPOSES THEREIN SET FORTH.

IN WITNESS WHEREOF, I HAVE HEREUNTO SET MY HAND AND OFFICIAL SEAL THE DAY AND YEAR LAST ABOVE WRITTEN.

MY COMMISSION EXPIRES: MARCH 23, 1960

Jerry E. Shawver
JERRY E. SHAWVER
Anna M. Matzke
NOTARY PUBLIC

FILE SEC. 21 T. 21 R. 1W
BOOK PAGE 115 LINE 21