

STATE OF KANSAS
STATE CORPORATION COMMISSION


WELL PLUGGING RECORD

FORMATION PLUGGING RECORD

Give All Information Completely
Make Required Affidavit
Mail or Deliver Report to:
Conservation Division
State Corporation Commission
800 Bittling Building
Wichita, Kansas.

Strike out upper line
when reporting plug-
ging of formations.

NORTH

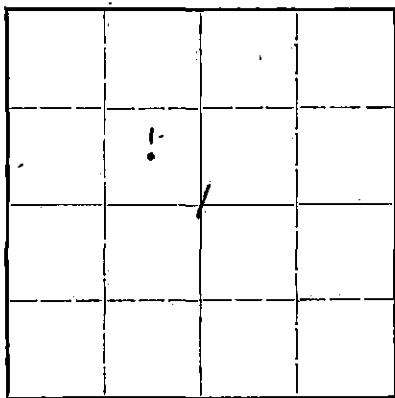

Locate well correctly on above
Section Plot

RICE County. Sec 1 Twp. 21S Rge. (E) 8 (W)
Location as "NE $\frac{1}{4}$ NW $\frac{1}{4}$ SW $\frac{1}{4}$ " or footage from lines SE/4-NW/4 SENE
Lease Owner THE ATLANTIC REFINING COMPANY
Lease Name HETER Well No. 1
Office Address P. O. Box # 17, Great Bend, Kansas
Character of Well (completed as Oil, Gas or Dry Hole) oil
Date well completed October 18, 19 37.
Application for plugging filed April 10, 19 46.
Application for plugging approved April 12, 19 46.
Plugging commenced July 18, 19 46.
Plugging completed July 22, 19 46.
Reason for abandonment of well or producing formation Depleted Formation

If a producing well is abandoned, date of last production February 25, 19 46.
Was permission obtained from the Conservation Division or its agents before plugging was com-
menced? Yes

Name of Conservation Agent who supervised plugging of this well Ruel Durkee
Producing formation Conglomerate Depth to top 3335' Bottom 3341' Total Depth of Well 3364' Feet
Show depth and thickness of all water, oil and gas formations.


OIL, GAS OR WATER RECORDS

CASING RECORD

Formation	Content	From	To	Size	Put In	Pulled Out
Conglomerate	Gas & Oil	3335'	3341'	10" O. D.	103'	None
				7" O. D.	3332'	2245'

Describe in detail the manner in which the well was plugged, indicating where the mud fluid was placed and the method or methods used in introducing it into the hold. If cement or other plugs were used, state the character of same and depth placed, from _____ feet to _____ feet for each plug set.

Mud from 3364' to 3332'.
Cement from 3332' to 3303' mud from 3303 to 150.
Cement from 150' to 117'
Mud from 117' to 10'
Cement from 10' to surface

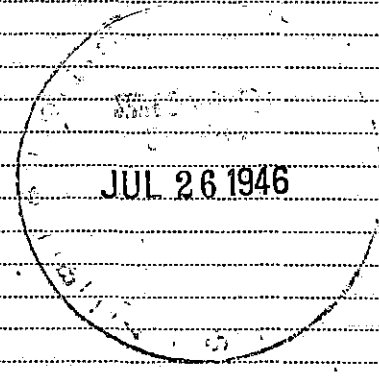

Handwritten notes: 21.8W, 49.38

(If additional description is necessary, use BACK of this sheet)

Correspondence regarding this well should be addressed to THE ATLANTIC REFINING COMPANY
Address P.O. BOX # 17, GREAT BEND, KANSAS.

STATE OF KANSAS, COUNTY OF BARTON, SS.
STANTON K. MYERS (employee of owner) or (owner or operator) of the above-described well,
being first duly sworn on oath, says: That I have knowledge of the facts, statements, and matters herein contained and the log of the above-
described well as filed and that the same are true and correct. So help me God.

(Signature) Stanton K Myers

(Address)

SUBSCRIBED AND SWORN to before me this 24th day of July, 19 46.

H. C. Colegrove
Notary Public.

My commission expires Oct 28, 1948.

WELL RECORD

15.159.05502-0000

THE ATLANTIC REFINING COMPANY
OPERATOR

Block or Twp. 21S-8W

Lease Heter
Lease No KS-6414
County Rice

Well No. 1
State Kansas

Location SE corner of NE 1/4 of
Sec. 1-21S-8W
Elevation 1639 Feet

Drilled { Contract x
 { Company Tools

Contracted Depth
Completed Depth 3364

Feet (Started 9-7-37
Feet Date) Completed 10-2-37-10-12-37
Deepened
Cleaned Out

Name of Contractor Reading & Bates

Drilling Comp. 10-2-37
Well comp. 10-12-37
Cleaned out and swabbed

Contract Price Per Foot

Day Work from 10-4 to 10-12

Well Estimated Cost
Well Actual Cost

Method of Drilling

BEFORE SHOOTING

AFTER SHOOTING

Initial Production 539 bbls. Flowing
Settled Production on Pump

Initial Production Flowing
Settled Production on Pump

Baume Test Water With Oil %

Casing Record			Torpedo Record				Size of Shell	Total Qts.
SIZE	SET	PULLED	Date	Company	From	To		
10"	103'	100 sacks						
7"	3332	150 "						

<u>FORMATION</u>	<u>TOP</u>	<u>BOTTOM</u>
Sand and red bed	0	103
Shale	103	925
Shale and lime	925	1122
Lime	1122	1247
Lime and Sand	1247	1367
Lime	1367	1624
Lime shells and shale	1624	1714
Broken lime and shale	1714	1930
Lime and shale	1930	2037
Shale	2037	2116
Broken lime and shale	2116	2325
Lime	2325	2374
Lime and shale	2374	2443
Lime	2443	2770
Broken lime and sand	2770	2843
Lime	2843	3280
Broken lime	3280	3315
Lime	3315	3321
Shale	3321	3335
Conglomerate	3335	3340
Conglomerate	3340	3345
Shale	3345	3347
Conglomerate	3347	3350
Chat	3350	3354
Conglomerate and chat	3354	3358
Hard chat	3358	3361
Conglomerate and chat	3361	3364
Total depth		3364

1 21 8W
49 38

Cored from 3321 to 3335

