

COPY

CONFIDENTIAL

CONFIDENTIAL

SIDE ONE

STATE CORPORATION COMMISSION OF KANSAS
OIL & GAS CONSERVATION DIVISION
WELL COMPLETION FORM
ACO-1 WELL HISTORY
DESCRIPTION OF WELL AND LEASE

API NO. 15- 075-20,444-0000

County Hamilton

SE/4 Sec. 14 Twp. 21S Rge. 41 East
West

1320 Ft. North from Southeast Corner of Section

1320 Ft. West from Southeast Corner of Section
(NOTE: Locate well in section plat below.)


Lease Name HCU Well # 1411-C

Field Name Bradshaw

Producing Formation Winfield

Elevation: Ground 3615 KB

Total Depth 2900 PBTD 2849

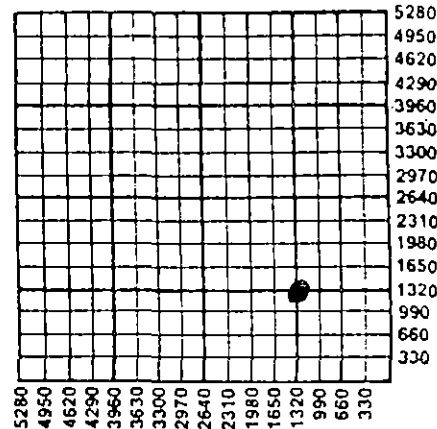

8-22-90

Operator: License # 04680

Name: American Exploration Co.

Address 2100 NCNB Center

700 Louisiana

City/State/Zip Houston, Texas 77002

Purchaser: KN Energy

Operator Contact Person: Marty B. McClanahan

Phone (713) 220-8251

Contractor: Name: Cheyenne Drilling Co.

License: 5382

Wellsite Geologist: Gary Oliver

Designate Type of Completion

New Well Re-Entry Workover

Oil SWD Temp. Abd.

Gas Inj Delayed Comp.

Dry Other (Core, Water Supply, etc.)

If OWMO: old well info as follows:

Operator: _____

Well Name: _____

Comp. Date _____ Old Total Depth _____

Drilling Method:

Mud Rotary Air Rotary Cable

4/26/90 4/29/90 6/22/90

Spud Date Date Reached TD Completion Date

Point of Surface Pipe Set and Cemented at 367 Feet

Multiple Stage Cementing Collar Used? Yes No

Yes, show depth set _____ Feet

If Alternate II completion, cement circulated from 367 2903

feet depth to Surface w/ 350 825 sx cmt.

INSTRUCTIONS: This form shall be completed in triplicate and filed with the Kansas Corporation Commission, 200 Colorado Derby Building, Wichita, Kansas 67202, within 120 days of the spud date of any well. Rule 82-3-130, 82-3-107 and 82-3-106 apply. Information on side two of this form will be held confidential for a period of 12 months if requested in writing and submitted with the form. See rule 82-3-107 for confidentiality in excess of 12 months. One copy of all wireline logs and drillers time log shall be attached with this form. ALL CEMENTING TICKETS MUST BE ATTACHED. Submit CP-4 form with all plugged wells. Submit CP-111 form with all temporarily abandoned wells. Any recompletion, workover or conversion of a well requires filing of ACO-2 within 120 days from commencement date of such work.

All requirements of the statutes, rules and regulations promulgated to regulate the oil and gas industry have been fully complied with and the statements herein are complete and correct to the best of my knowledge.


Signature Marty B. McClanahan

Title Production Analyst Date 8/08/90

Subscribed and sworn to before me this 9 day of August, 19 90.

Notary Public [Signature] in and for Harris County, Texas

Date Commission Expires AUG. 25, 1990

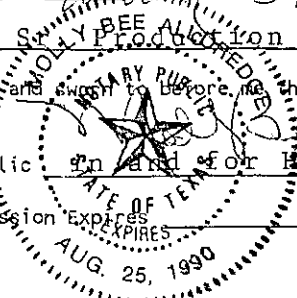

K.C.C. OFFICE USE ONLY

F Letter of Confidentiality Attached

C Wireline Log Received

C Drillers Timelog Received

Distribution

KCC SWD/Rep NGPA

KGS Plug Other (Specify)

PI