

STATE OF KANSAS
STATE CORPORATION COMMISSION


Give All Information Completely
Make Required Affidavit
Mail or Deliver Report to:
Conservation Division
State Corporation Commission
211 No. Broadway
Wichita, Kansas

WELL PLUGGING RECORD

Rice County. Sec. 8 Twp. 21S Rge. (E) 8 (W)

Location as "NE/CNW&SW" or footage from lines S/2 NE NE
Lease Owner Raymond Oil Company, Inc.
Lease Name Timbers Well No. 2
Office Address 410 Fourth National Bank Building, Wichita, Kansas
Character of Well (completed as Oil, Gas or Dry Hole) Dry Hole
Date well completed January 5, 1967 19
Application for plugging filed January 16, 1967 19
Application for plugging approved January 10, 1967 19
Plugging commenced January 5, 1967 19
Plugging completed January 5, 1967 19
Reason for abandonment of well or producing formation

NORTH

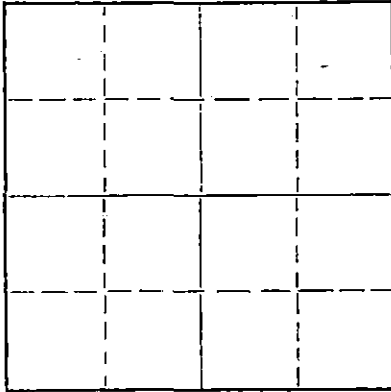

Locate well correctly on above
Section Plat

If a producing well is abandoned, date of last production 19
Was permission obtained from the Conservation Division or its agents before plugging was commenced? Yes

Name of Conservation Agent who supervised plugging of this well Gilbert Toman
Producing formation Depth to top Bottom Total Depth of Well Feet
Show depth and thickness of all water, oil and gas formations.


OIL, GAS OR WATER RECORDS

CASING RECORD

FORMATION	CONTENT	FROM	TO	SIZE	PUT IN	PULLED OUT
				8-5/8"	211'	

Describe in detail the manner in which the well was plugged, indicating where the mud fluid was placed and the method or methods used in introducing it into the hole. If cement or other plugs were used, state the character of same and depth placed, from feet to feet for each plug set.

Fill hole up to 200' w/mud, plugged with 1/4 sacks hulls,
25 sacks cement, bottom plug
fill w/mud to 40 feet, set plug with 1/2 sacks hulls, bridge to hold Kelly
10 sacks cement on top plug, 2 sacks cement in rat hole.

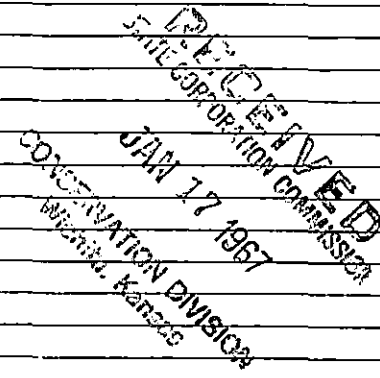

(If additional description is necessary, use BACK of this sheet)
Name of Plugging Contractor Raymond Oil Company, Inc.
Address 410 Fourth National Bank Building, Wichita, Kansas 67202

STATE OF KANSAS, COUNTY OF SEDGWICK, ss.
Wm. M. Raymond (employee or operator) of the above-described well, being first duly sworn on oath, says: That I have knowledge of the facts, statements, and matters herein contained and the log of the above-described well as filed and that the same are true and correct. So help me God.

(Signature) Wm M Raymond
410 Fourth National Bank Bldg., Wichita, Ks. (Address)

SUBSCRIBED AND SWORN TO before me this 16th day of January 19 67

My commission expires February 15, 1967

Ronnie Donnelly Notary Public

RAYMOND OIL COMPANY, INC.
 #2 TIMBERS
 S/2 NE NE Sec. 8-21S-8W
 Rice County, Kansas

ELEVATION: 1657 KB
 1655 DF
 1652 GL

Drilling Contractor: Company Tools Casing Record
 Date Commenced: December 20, 1966 8-5/8" @ 211' w/225 sx.
 Date Completed: January 5, 1967

Figures Indicate Bottom of Formation

<u>Formation</u>	<u>Depth</u>
Anhydrite	216
Anhydrite Shale & Shells	700
Shale & Shells	825
Shale	1047
Lime & Shale	1810
Shale & Lime	2360
Lime & Shale	2429
Topeka Lime	2477
Lime	2485
Lime & Shale	2731
Heebner Shale	2736
Shale & Lime	2780
Shale	2869
Brown Lime	2870
Lime & Shale	3061
Lime	3093
Lime w/Shale	3142
Lime & Shale	3341
Sand	3364
Lime & Viola	3394
RTD	3394

RECEIVED
 STATE CORPORATION COMMISSION
 JAN 17 1967
 CONSERVATION DIVISION
 Wichita, Kansas

STATE OF KANSAS)
) SS:
 COUNTY OF SEDGWICK)

I hereby certify that the above is true and correct to the best of my knowledge.

Wm. M. Raymond
 Wm. M. Raymond

SUBSCRIBED and sworn to before me this 13th day of January, 1967.

Ronnie Donnelly
 Ronnie Donnelly - Notary Public

My commission expires:

February 15, 1967