

STATE OF KANSAS
STATE CORPORATION COMMISSION


Give All Information Completely
Make Required Affidavit
Mail or Deliver Report to:
Conservation Division
State Corporation Commission
800 Bittling Building
Wichita, Kansas

WELL PLUGGING RECORD

OR

FORMATION PLUGGING RECORD

Strike out upper line
when reporting plug-
ging off formations.

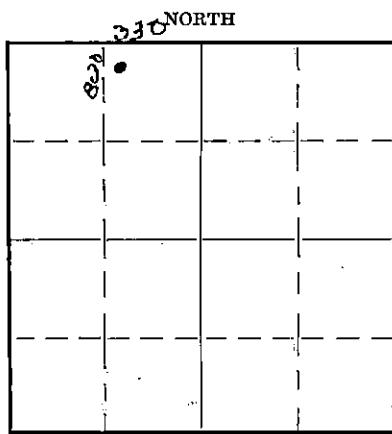

Locate well correctly on above
Section Plat

Rice County, Sec. 8 Twp. 21 Rge. 8 (W)
Location as "NE 1/4 NW 1/4 SW 1/4" or footage from lines 330 South 330 East
Lease Owner. Henderson Shipy Co.
Lease Name. Timbers Well No. 1
Office Address. Box 1565 Tulsa, Okla.
Character of Well (Completed as Oil, Gas or Dry Hole) dry hole
Date, well completed. 5-17-41 193.
Application for plugging filed 5-16-41 193.
Application for plugging approved 5-16-41 193.
Plugging Commenced. 5-17-41 193.
Plugging Completed. 5-17-41 193.
Reason for abandonment of well or producing formation Water.

If a producing well is abandoned, date of last production 193.
Was permission obtained from the Conservation Division or its agents before plugging was commenced?

Name of Conservation Agent who supervised plugging of this well. Rural Durkey
Producing formation. None Depth to top. Bottom. Total Depth of Well. 3520 Feet.
Show depth and thickness of all water, oil and gas formations.



OIL, GAS OR WATER RECORDS

CASING RECORD

Formation	Content	From	To	Size	Put In	Pulled Out
<u>Mixer Sand</u>	<u>Water</u>	<u>3348</u>	<u>3553</u>	<u>5 1/2 O.D.</u>	<u>3519</u>	<u>1400.</u>

Describe in detail the manner in which the well was plugged, indicating where the mud fluid was placed and the method or methods used in introducing it into the hole. If cement or other plugs were used, state the character of same and depth placed, from feet to feet for each plug set.

5 1/2 O.D. Pipe Cemented 3519 ft. Plugged with
Cement 3519-3502. Pipe shot off Circulated
with heavy mud.
Cement Plug set 200 ft. 10 sacks of Cement on
top of it filled with mud to 18 ft below Cella
Wood plug set and filled to top with cement.
Steel cap welded over surface pipe.

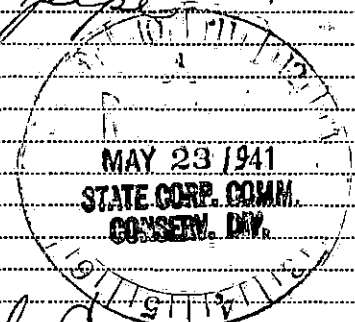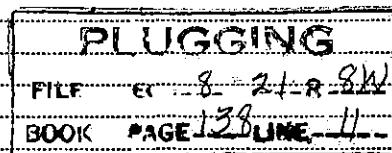

(If additional description is necessary, use BACK of this sheet)

Correspondence regarding this well should be addressed to Henderson Shipy Co.
Address Box 1565 Tulsa Oklahoma.

STATE OF Kansas COUNTY OF See SS.
H. H. Butcher (employee of owner) or (owner or operator) of the above-described well,
being first duly sworn on oath, says: That I have knowledge of the facts, statements, and matters herein contained and the log of the above-described well as filed and that the same are true and correct. So help me God.

(Signature)

H. H. Butcher

(Address)

Lyon, Kansas
May 4 1941SUBSCRIBED AND SWORN TO before me this 22 day of May, 1941

My commission expires

Jan 7 1942

17-6058

10-38-6M

Notary Public.