


STATE OF KANSAS  
STATE CORPORATION COMMISSION

Form CP-4

Give All Information Completely  
Make Required Affidavit  
Mail or Deliver Report to:  
Conservation Division  
State Corporation Commission  
212 No. Market  
Wichita, Kansas

WELL PLUGGING RECORD

NORTH

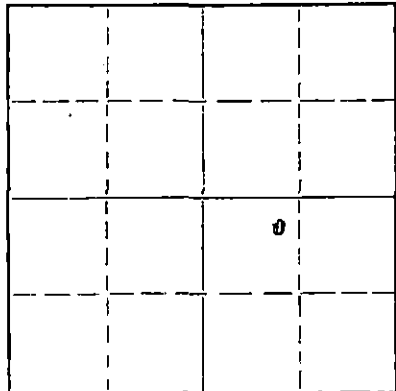

Locate well correctly on above  
Section Plat

RICE County. Sec. 8 Twp. 21S Rge. 8W (E) (W)  
Location as "NE/CNW/SW" or footage from lines NE NW SE  
Lease Owner KANOCO OIL COMPANY  
Lease Name Blackhall Well No. 1  
Office Address 619 First National Bank Building - Wichita, Kansas  
Character of Well (completed as Oil, Gas or Dry Hole) Dry Hole  
Date well completed 11-9 19 66  
Application for plugging filed 11-9 19 66  
Application for plugging approved 11-9 19 66  
Plugging commenced 11-9 19 66  
Plugging completed 7:00 11-9 19 66  
Reason for abandonment of well or producing formation Dry

If a producing well is abandoned, date of last production none 19  
Was permission obtained from the Conservation Division or its agents before plugging was commenced? yes

Name of Conservation Agent who supervised plugging of this well Don Truman - Holyrood, Kansas  
Producing formation none Depth to top Bottom Total Depth of Well 3616 Feet  
Show depth and thickness of all water, oil and gas formations.

OIL, GAS OR WATER RECORDS

CASING RECORD

FORMATION	CONTENT	FROM	TO	SIZE	PUT IN	PULLED OUT
<u>Lime &amp; Shale</u>		<u>0</u>	<u>215</u>	<u>12 1/2</u>	<u>215</u>	

Describe in detail the manner in which the well was plugged, indicating where the mud fluid was placed and the method or methods used in introducing it into the hole. If cement or other plugs were used, state the character of same and depth placed, from feet to feet for each plug set.

Fluid @ 50' add 1/4 sack Hulls and plug at 200' Mixed 25 sacks cement thru drill pipe Put Hulls and Plug at 40' & bridged to hold up Kelly add 10 sack - Plugged rat hole with 2 sacks.

RECEIVED  
STATE CORPORATION COMMISSION

NOV 17 1966

CONSERVATION DIVISION  
WICHITA, KANSAS

(If additional description is necessary, use BACK of this sheet)  
Name of Plugging Contractor B & B Drilling Inc.  
Address 548 Petroleum Building - Wichita, Kansas

STATE OF Kansas, COUNTY OF Sedgwick, ss.  
Bill Lahar (employee of owner) or (owner or operator) of the above-described well, being first duly sworn on oath, says: That I have knowledge of the facts, statements, and matters herein contained and the log of the above-described well as filed and that the same are true and correct. So help me God.

(Signature) Bill Lahar  
548 Petroleum Building - Wichita, Kansas  
(Address)

SUBSCRIBED AND SWORN TO before me this 16th day of November, 19 66

My commission expires May 31, 1970 Alma C Neiser Notary Public.

**B & B DRILLING, INC.**

548 Petroleum Building  
 Wichita, Kansas 67202  
 November 14, 1966

DRILLERS LOG

Re: Blackhall #1  
 NE NW SE  
 Sec. 8-21S-8W  
 Rice County, Kansas

**COMPANY:** Kanoco Oil Company  
 619 First National Bank Building  
 Wichita, Kansas

**CONTRACTOR:** B & B Drilling Inc.  
**TOTAL DEPTH:** 3610'  
**COMMENCED:** November 2, 1966  
**COMPLETED:** November 9, 1966

RECEIVED  
 STATE CORPORATION COMMISSION

NOV 15 1966

CONSERVATION DIVISION  
 -Wichita, Kansas

0	80	Sand
80	215	Red Bed
215	615	Shale & Red Bed
615	1050	Shale
1050	1300	Shale & Lime
1300	1560	Shale & Lime
1560	1840	Lime & Shale
1840	2370	Shale
2370	2529	Shale & Lime
2529	2760	Shale & Lime
2760	2925	Lime & Shale
2925	3230	Lime & Shale
3230	3452	Lime & Shale
3452	3610	Lime & Shale
3610		total depth
3610	3616	Log TD D & A

We certify the above and foregoing to be true and correct copy of the log on the Blackhall #1, located in Rice County, Kansas

B & B DRILLING INC.

Bill Daboi President

Alfred A. Meiser Notary Public

Subscribed and sworn to before me this  
 14th day of November, 1966

My commission expires  
 May 31, 1970