

WELL PLUGGING RECORD


STATE OF KANSAS STATE CORPORATION COMMISSION

FORMATION PLUGGING RECORD

Give All Information Completely Make Required Affidavit Mail or Deliver Report to: Conservation Division State Corporation Commission 800 Biting Building Wichita, Kansas

Strike out upper line when reporting plugging off formations.

NORTH

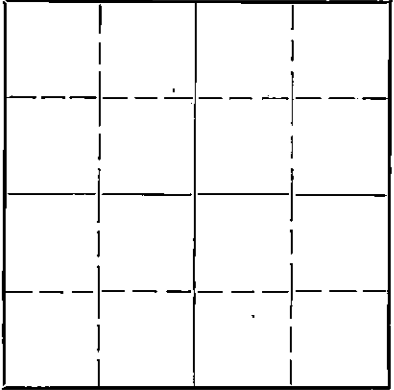

Locate well correctly on above Section Plat

Rice County, Sec 7, Twp 21, Rge 8 (E) W Location as "NE 1/4 NW 1/4 SW 1/4" or footage from lines Contor W 1/2 SW 1/4 95 1/2 Lease Owner Falcon Seaboard Drilling Company Lease Name Blackhall Well No 1 Office Address Union National Bank Bldg., Wichita, Kansas Character of Well (completed as Oil, Gas or Dry Hole) Dry Hole Date well completed August 24th 1943 Application for plugging filed August 24th 1943 Application for plugging approved August 24th 19 43 Plugging commenced August 24th 1943 Plugging completed August 24th 1943 Reason for abandonment of well or producing formation Dry Hole

If a producing well is abandoned, date of last production 19 Was permission obtained from the Conservation Division or its agents before plugging was commenced? Yes

Name of Conservation Agent who supervised plugging of this well Mr. Durkos Producing formation Depth to top Bottom Total Depth of Well 304 Feet Show depth and thickness of all water, oil and gas formations.

OIL, GAS OR WATER RECORDS

CASING RECORD

Table with 7 columns: Formation, Content, From, To, Size, Put In, Pulled Out. Row 1: Water Sand, Water, 8', 30', 10 3/4", 167'

Describe in detail the manner in which the well was plugged, indicating where the mud fluid was placed and the method or methods used in introducing it into the hole. If cement or other plugs were used, state the character of same and depth placed, from feet to feet for each plug set.

Heavy Mud from 304' to 170' Permanent plug set @ 170' Cemented from 170' to 145' Heavy Mud 145' to 15' Cement from 15' to 5'

FILE 7 21 800 BOOK PAGE 89 11

9-1-43

(If additional description is necessary, use BACK of this sheet)

Correspondence regarding this well should be addressed to Falcon Seaboard Drilling Company Address Union National Bank Bldg., Wichita, Kansas.

STATE OF Kansas COUNTY OF Sedgwick Jim Adkins (employee of owner) or (owner or operator) of the above-described well, being first duly sworn on oath, says: That I have knowledge of the facts, statements, and matters herein contained and the log of the above-described well as filed and that the same are true and correct. So help me God.

(Signature) Jim Adkins 1502- 12th St., Great Bend, Kansas. (Address)

SUBSCRIBED AND SWORN to before me this 30th day of August, 1943. Margaret O'Reilly Notary Public.

My commission expires April 7, 1947

FALCON-SHARBOARD DRILLING COMPANY'S BLACKHALL #1


Center of West line of W 20 A of S4SE1/4 of
Sec. 7, Township 21S, Range 8W, Rice, Co.,
Kansas.

Started rigging up 8-4-43.
Tearing out rotary 8-25-43

Set 4 jts. 10 1/2" spiral weld casing, tally 160',
set at 157' with 125 sacks cement. 10' cement
left in pipe.

Pulled pipe out of hole and plugged hole-8-24-43.

<u>FORMATION</u>	<u>FROM</u>	<u>TO</u>	<u>REMARKS</u>
Sand	0	80	
Red Bed & Shells	80	200	
Shale & Shells	200	235	
Sand	235	285	
Shale and shells	285	770	
Lime	770	800	
Salt	800	885	Slope test 850' OK
Salt and shells	885	1050	
Shale and lime	1050	1210	
Shale and shells	1210	1300	
Lime	1300	1435	Slope test 1350' OK
Shale	1435	1450	
Shale and shells	1450	1565	
Shale	1565	1615	
Lime	1615	1670	
Shale and shells	1670	1765	
Lime	1765	1800	
Shale and shells	1800	1850	Slope test 1850' OK
Lime	1850	1920	
Shale	1920	1955	
Shale and shells	1955	2340	
Lime	2340	2390	
Shale and shells	2390	2475	
Lime and shale	2475	2545	
Lime	2545	2635	
Shale and shells	2635	2720	
Lime and shale	2720	2800	Slope test 2750' OK
Lime	2900	3272	
Shale	3273	3350	
Lime	3350	3402	
Shale	3402	3440	
Shale and lime	3440	3491	
Lime	3491	3520	
Lime and shale	3520	3548	
Lime	3548	3576	
Shale	3576	3607	
Lime, arbutle	3607	3640	

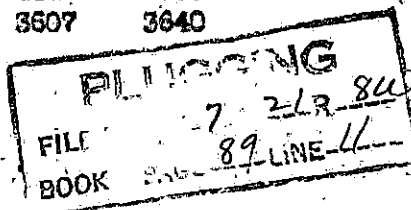

I, W. A. Grant, partner of Harbor Drilling Company, certify that to the best of my knowledge and belief, the above log is true and correct.

W. A. Grant

Subscribed and sworn to before me this 30th day of August, 1943
My commission expires April 7, 1947

Margaret O'Reilly
Notary Public

