

STATE OF KANSAS
STATE CORPORATION COMMISSION


WELL PLUGGING RECORD

Give All Information Completely
Make Required Affidavit
Mail or Deliver Report to:
Conservation Division
State Corporation Commission
211 No. Broadway
Wichita, Kansas

Rice County. Sec. 32 Twp. 21S Rge. 10 (E) (W)

Location as "NE/CNW/SW" or footage from lines SW SE NW
Lease Owner Schermerhorn Oil Corporation
Lease Name Byron "B" Well No. 1
Office Address Box 287 - Tulsa, Oklahoma
Character of Well (completed as Oil, Gas or Dry Hole) Dry Hole
Date well completed 10-4 1957
Application for plugging filed 10-4 1957
Application for plugging approved 10-4 1957
Plugging commenced 9:00 A.M. 10-4 1957
Plugging completed 12:00 A.M. 10-4 1957
Reason for abandonment of well or producing formation Dry Hole

NORTH

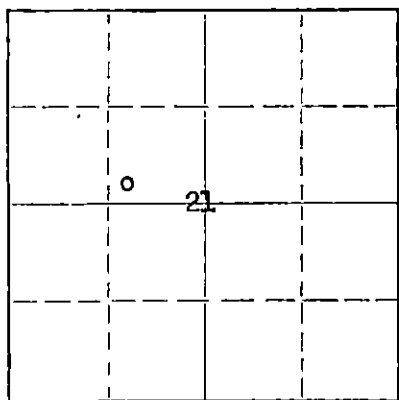

Locate well correctly on above
Section Plot

If a producing well is abandoned, date of last production -- 19
Was permission obtained from the Conservation Division or its agents before plugging was commenced? Yes

Name of Conservation Agent who supervised plugging of this well Durke
Producing formation None Depth to top Bottom Total Depth of Well 3555 Feet
Show depth and thickness of all water, oil and gas formations.

OIL, GAS OR WATER RECORDS

CASING RECORD

FORMATION	CONTENT	FROM	TO	SIZE	PUT IN	PULLED OUT
Sand & Gravel	Water	30	160	8-5/8	240	None

Describe in detail the manner in which the well was plugged, indicating where the mud fluid was placed and the method or methods used in introducing it into the hole. If cement or other plugs were used, state the character of same and depth placed, from feet to feet for each plug set.

Heavy mud pumped to bottom of hole and filled to 225'; bridged at 225'; 15 sacks cement spotted at 225'; hole filled with heavy mud to 15' and bridged; 5 sacks cement from 15' to bottom of cellar.

(If additional description is necessary, use BACK of this sheet)

Name of Plugging Contractor Badger Drillers, Inc.
Address Box 287 - Tulsa, Oklahoma

STATE OF OKLAHOMA, COUNTY OF TULSA, ss.
F. M. Hamner (employee of owner) or (owner/representative) of the above-described

well, being first duly sworn on oath, says: That I have knowledge of the facts, statements, and matters herein contained and the log of the above-described well as filed and that the same are true and correct. So help me God.

(Signature) F. M. Hamner
Box 287 - Tulsa, Oklahoma (Address)

SUBSCRIBED AND SWORN TO before me this 8th day of October, 19 57
Martha Miller Notary Public.

My commission expires 6-26-60

PLUGGING
FILE SEC 32 T 21 R 10 W
BOOK PAGE 51 LINE 36

DRILLER'S LOG

Schermerhorn Oil Corporation
 Byron "B" #1
 SW SE ~~1/4~~
 Sec. 32-21S-10W
 Rice Co., Kansas

DRILLING COMMENCED: September 25, 1957

DRILLING COMPLETED: October 4, 1957

CASING RECORD: 8-5/8" casing cemented at 240' w/200 sacks.

FORMATION RECORD

Sand & Shale	0	175
Redbed	175	590
Shale & Shells	590	1380
Lime & Shale	1380	1720
Lime	1720	1950
Lime & Shale	1950	2870
Lime	2870	3395
Lime & Chert	3395	3465
Lime	3465	3555 R.T.D.

I hereby certify that this is a true and correct log
 of the above mentioned well.

BADGER DRILLERS, INC.

By J. P. [Signature]

STATE OF OKLAHOMA) SS:
 COUNTY OF TULSA)

Subscribed to and sworn to before me, a Notary Public,
 in said County and State, this 8th day of October, 1957.

Martha Maher
 Notary Public

My Commission expires: 6-26-60

PLUGGING	
FILE SEC	32 T. 21 R. 10W
BOOK PAGE	51 LINE 36

RECORDED
 STATE COMMISSIONER OF DEPT. OF REVENUE
 OCT 9 1957
 DIVISION
 Wichita, Kansas