

CARD MUST BE TYPED

State of Kansas
NOTICE OF INTENTION TO DRILL
 (see rules on reverse side)

CARD MUST BE SIGNED

 Starting Date: Nov. 23 1985
 month day year

 OPERATOR: License # 5407
 Name Hupfer Oil & Gas
 Address 3711 Country Lane
 City/State/Zip Hays, Kansas 67601
 Contact Person Dennis D. Hupfer
 Phone 913-628-8666

 CONTRACTOR: License # 5107
 Name H-30, Inc.
 City/State Wichita, Kansas 67202

Well Drilled For:	Well Class:	Type Equipment:
<input checked="" type="checkbox"/> Oil <input type="checkbox"/> Swd <input type="checkbox"/> Infield	<input checked="" type="checkbox"/> Mud Rotary	<input type="checkbox"/> Air Rotary
<input type="checkbox"/> Gas <input type="checkbox"/> Inj <input type="checkbox"/> Pool Ext.	<input type="checkbox"/> Cable	
<input type="checkbox"/> OWWO <input type="checkbox"/> Expl <input checked="" type="checkbox"/> Wildcat		

If OWWO: old well info as follows:

 Operator
 Well Name
 Comp Date Old Total Depth
 Projected Total Depth 3850 feet
 Projected Formation at TD Arbuckle
 Expected Producing Formations Arbuckle

I certify that we will comply with K.S.A. 55-101, et seq., plus eventually plugging hole to K.C.C. specifications.

Date Nov. 6, 85. Signature of Operator or Agent

Dennis D. Hupfer

API Number IS- 145-21,230-0000

 SW.. NE .NW Sec 14. Twp 21.. S, Rge 16. East
 (location) West

 4290 Ft North from Southeast Corner of Section
 3630 Ft West from Southeast Corner of Section
 (Note: Locate well on Section Plat on reverse side)

 Nearest lease or unit boundary line 990 feet.
 County Pawnee
 Lease Name Bailey Well# 1

 Domestic well within 330 feet : yes no
 Municipal well within one mile : yes no


 Depth to Bottom of fresh water 60 feet
 Lowest usable water formation Cheyenne
 Depth to Bottom of usable water 215 feet
 Surface pipe by Alternate : 1 2
 Surface pipe to be set 980 feet
 Conductor pipe if any required N/A feet
 Ground surface elevation 1965 feet MSL
 This Authorization Expires 5-7-86
 Approved By 11-7-85 [Signature]

President

Must be filed with the K.C.C. five (5) days prior to commencing well
 This card void if drilling not started within six (6) months of date received by K.C.C.

Important procedures to follow :

**A Regular Section of Land
 1 Mile = 5,280 Ft.**

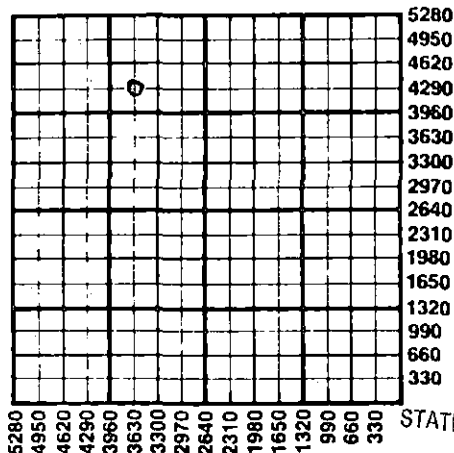

1. Notify District office before setting surface casing.
2. Set surface casing by circulating cement to the top.
3. File completion forms ACO-1 with K.C.C. within 90 days of well completion, following instructions on ACO-1, side 1, and including copies of wireline logs.
4. Notify District office 48 hours prior to old well workover or re-entry.
5. Prior to plugging, prepare a plugging plan, then obtain agreement from the appropriate district office for an approved plugging plan.
6. Submit plugging report (CP-4) to K.C.C. after plugging is completed.
7. Obtain an approved injection docket number before disposing of salt water.
8. Notify K.C.C. within 10 days when injection commences or terminates.
9. If an alternate 2 completion, cement in the production pipe from below any usable water to surface within 120 days of spud date.

RECEIVED
 STATE CORPORATION COMMISSION

State Corporation Commission of Kansas
 Conservation Division
 200 Colorado Derby Building
 Wichita, Kansas 67202
 (316) 263-3238

NOV 7 1985
 11-7-85
 CONSERVATION DIVISION
 Wichita, Kansas