

CARD MUST BE TYPED

State of Kansas
NOTICE OF INTENTION TO DRILL
(see rules on reverse side)

CARD MUST BE SIGNED

Starting Date: February 22, 1985
month day year

API Number 15-145-21,188
2nd CORRECTION (Township typo) 3-6-85

OPERATOR: License # 8624
Name Genesis Oil and Gas, Inc.
Address 1505 KSB Building
City/State/Zip Wichita, Kansas 67202
Contact Person Ray Williams
Phone 316-264-1637

* SE SE SE Sec 24 Twp 23 S, Rge 15
(location) East West

330 Ft North from Southeast Corner of Section
330 Ft West from Southeast Corner of Section
(Note: Locate well on Section Plat on reverse side)

CONTRACTOR: License # 5418
Name Allen Drilling
City/State Great Bend, Kansas

Nearest lease or unit boundary line 330 feet.
County Pawnee
Lease Name Murphy Well# 1

Well Drilled For: Well Class: Type Equipment:
 Oil Swd Infield Mud Rotary
 Gas Inj Pool Ext. Air Rotary
 OWWO Expl Wildcat Cable

Domestic well within 330 feet: yes no
Municipal well within one mile: yes no

If OWWO: old well info as follows:
Operator
Well Name
Comp Date Old Total Depth
Projected Total Depth 4200 feet
Projected Formation at TD Arbuckle
Expected Producing Formations Lansing Arbuckle

Depth to Bottom of fresh water 150 feet
Lowest usable water formation
Depth to Bottom of usable water 320 feet
Surface pipe by Alternate: 1 2
Surface pipe to be set 320 feet
Conductor pipe if any required
Ground surface elevation 1990 feet MSL
This Authorization Expires 8/18/85
Approved By 2/18/85

I certify that we will comply with K.S.A. 55-101, et seq., plus eventually plugging hole to K.C.C. specifications. *was 24-21g-15w*


Date 3/4/85 Signature of Operator or Agent *[Signature]*

Title President

Must be filed with the K.C.C. five (5) days prior to commencing well
This card void if drilling not started within six (6) months of date received by K.C.C.

Important procedures to follow :

**A Regular Section of Land
1 Mile = 5,280 Ft.**

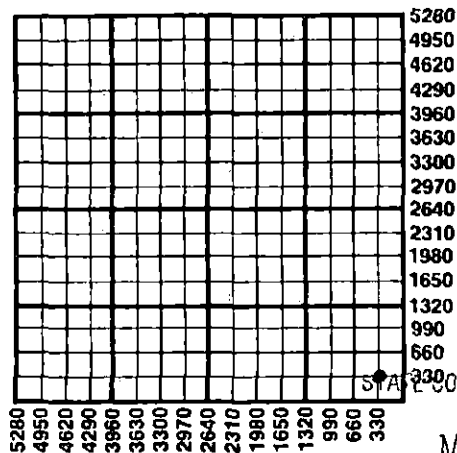

1. Notify District office before setting surface casing.
 2. Set surface casing by circulating cement to the top.
 3. File completion forms ACO-1 with K.C.C. within 90 days of well completion, following instructions on ACO-1, side 1, and including copies of wireline logs.
 4. Notify District office 48 hours prior to old well workover or re-entry.
 5. Prior to plugging, prepare a plugging plan, then obtain agreement from the appropriate district office for an approved plugging plan.
 6. Submit plugging report (CP-4) to K.C.C. after plugging is completed.
 7. Obtain an approved injection docket number before disposing of salt water.
 8. Notify K.C.C. within 10 days when injection commences or terminates.
9. If an alternate 2 completion, cement in the production pipe from below any usable water to surface within 120 days of spud date.

RECEIVED
MAR 06 1985

CONSERVATION DIVISION
Wichita, Kansas

3-6-85

State Corporation Commission of Kansas
Conservation Division
200 Colorado Derby Building
Wichita, Kansas 67202
(316) 263-3238