


15-145. 20401-0000

STATE OF KANSAS
STATE CORPORATION COMMISSION
CONSERVATION DIVISION
P. O. BOX 17027
WICHITA, KANSAS 67217

FORM CP-4

WELL PLUGGING RECORD

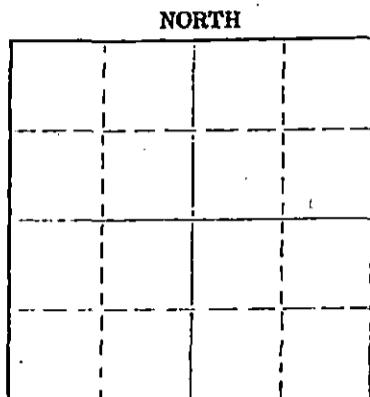

Locate well correctly on above Section Plot

Pawnee County. Sec. 8 Twp. 23S Rge. 16W (EX (W)
Location as "NE/CNW/SW" or footage from lines. 2310' FSL and 330' FWL - S/2
Lease Owner Voyager Petroleum, Kansas-Nebraska Nat Gas, Sterling
Lease Name Exxon Scharitz #1 Well No. 1 Drilling
Office Address P. O. Box 129, Sterling, Kansas 67579 Company
Character of Well (completed as Oil, Gas or Dry Hole) Dry Hole
Date well completed August 15, 1975
Application for plugging filed August 15, 1975
Application for plugging approved August 15, 1975
Plugging commenced 10:00 PM August 15, 1975
Plugging completed 11:45PM, August 15, 1975
Reason for abandonment of well or producing formation Dry Hole

If a producing well is abandoned, date of last production 19
Was permission obtained from the Conservation Division or its agents before plugging was commenced? Yes

Name of Conservation Agent who supervised plugging of this well Leo Massey
Producing formation _____ Depth to top _____ Bottom _____ Total Depth of Well 1230'
Show depth and thickness of all water, oil and gas formations.

OIL, GAS OR WATER RECORDS

CASING RECORD

FORMATION	CONTENT	FROM	TO	SIZE	PUT IN	PULLED OUT
				8 5/8"	252'	None

Describe in detail the manner in which the well was plugged, indicating where the mud fluid was placed and the method or methods used in introducing it into the hole. If cement or other plugs were used, state the character of same and depth placed, from _____ feet for each plug set.

Filled hole with heavy mud.
Pushed plug to 400'. Plumped 50 sacks cement through O.E.D.P. Pumped 25 sacks cement at 240' through O.E.D.P. Solid bridge at 40' with plug and hulls. 10 sacks cement to surface and 2 sacks in rathole.

RECEIVED
STATE CORPORATION COMMISSION
AUG 19 1975
8-19-75
CONSERVATION DIVISION
Wichita, Kansas

(If additional description is necessary, use BACK of this sheet)
Name of Plugging Contractor Sterling Drilling Company
Address P. O. Box 129, Sterling, Kansas 67579

STATE OF KANSAS COUNTY OF RICE, ss.
F. A. Wuellner (employee of owner) or (owner or operator) of the above-described


well, being first duly sworn on oath, says: That I have knowledge of the facts, statements, and matters herein contained and the log of the above-described well as filed and that the same are true and correct. So help me God. **STERLING DRILLING COMPANY**

(Signature) F. A. Wuellner
F. A. Wuellner, Secretary
P. O. Box 129, Sterling, Kansas 67579
(Address)

and Sworn to before me this 16th day of August, 19 75

CHARLES HALL - NOTARY PUBLIC
My Commission Expires Jan. 6, 1978

Charles M. Hall
Charles M. Hall, Notary Public.

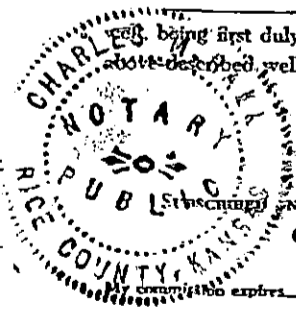

STERLING DRILLING COMPANY
P. O. Box 129
Sterling, Kansas 67579

15 145 70461-0000

WELL LOG ----- SCHARTZ #1

Located: S/2, Section 8-23S-16W, Pawnee County, Kansas

OWNER: Voyager Petroleum, Kansas-Nebraska Natural Gas, Sterling Drilling Company
ROTARY DRILLING CONTRACTOR: Sterling Drilling Company

COMMENCED: August 7, 1975
COMPLETED: August 15, 1975

TOTAL DEPTH: 4230'

<u>LOG</u>	<u>CASING RECORD</u>
0 - 255 Clay and Shale	Ran 6 joints new 8 5/8" casing, 240.90' set at 252' K.B. with 225 sacks 60/40 Pozmix with 3% cc. Plug down at 8:25 PM, 8-7-75, by Howco.
255 - 420 Shale and Red Bed	
420 - 1074 Red Beds and Sand	
1074 - 1096 Anhydrite	
1096 - 1180 Shale and Red Beds.	
1180 - 2005 Salt and Shale	
2005 - 3725 Lime and Shale	
3725 - 4080 Lime	
4080 - 4160 Lime and Chert	
4160 - 4175 Lime	
4175 - 4230 Lime, Shale, Chert	Flugged.

RECEIVED
STATE CORPORATION COMMISSION

AUG 19 1975

CONSERVATION DIVISION
Wichita, Kansas