


WELL PLUGGING RECORD

Give All Information Completely
Make Required Affidavit
Mail or Deliver Report to:
Conservation Division
State Corporation Commission
800 Bitting Building
Wichita, Kansas

NORTH

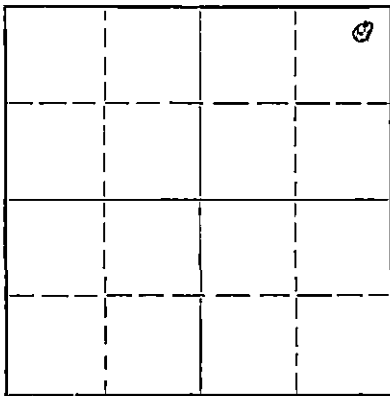

Locate well correctly on above
Section Plat

Pawnee County, Sec. 8 Twp. 23S Rge. (E) 16 (W)
Location as "NE/CNW $\frac{1}{4}$ /SW $\frac{1}{4}$ " or footage from lines NW NW NE
Lease Owner Tom-A-Rawk Petroleum Company
Lease Name Chas. Scharitz Well No. 1
Office Address 702 Fourth Nat'l Bank Bldg., Wichita, Kansas
Character of Well (completed as Oil, Gas or Dry Hole) Dry Hole
Date well completed 3-4-53 19
Application for plugging filed 3-4-53 19
Application for plugging approved 3-4-53 19
Plugging commenced 3-4-53 19
Plugging completed 3-4-53 19
Reason for abandonment of well or producing formation Dry Hole

If a producing well is abandoned, date of last production 19
Was permission obtained from the Conservation Division or its agents before plugging was commenced? Yes

Name of Conservation Agent who supervised plugging of this well
Producing formation Depth to top Bottom Total Depth of Well 4300 Feet
Show depth and thickness of all water, oil and gas formations.

OIL, GAS OR WATER RECORDS

CASING RECORD

| Formation | Content | From | To | Size | Put In | Pulled Out |
|-----------|---------|------|----|-------|--------|------------|
| | | | | 8-5/8 | 249.88 | None |
| | | | | | | |
| | | | | | | |
Describe in detail the manner in which the well was plugged, indicating where the mud fluid was placed and the method or methods used in introducing it into the hole. If cement or other plugs were used, state the character of same and depth placed, from feet to feet for each plug set.

Hole filled w/ heavy Mud
Bottom Plug set @ 240 feet cemented w/ 35 sacks cement
2nd Plug set 30 feet below cellar cemented w/ 15 sacks cement
Halliburton Oil Well Cementing Company equipment used

(If additional description is necessary, use BACK of this sheet)

Name of Plugging Contractor Iron Drilling Company
Address 1206 Philtower Bldg., Tulsa, Oklahoma

STATE OF Kansas, COUNTY OF Sedgwick, ss.
L. L. Cotter, Jr. (employee of owner) or (owner or operator) of the above-described well,

being first duly sworn on oath, says: That I have knowledge of the facts, statements, and matters herein contained and the log of the above-described well as filed and that the same are true and correct. So help me God.

(Signature) [Signature]
702 Fourth Nat'l. Bank Bldg., Wichita, Kans.
(Address)

SUBSCRIBED AND SWORN to before me this 16th day of March, 1953
My commission expires Oct. 11, 1954
[Signature] Notary Public.

My commission expires Oct. 11, 1954

23-8390-s 6-51-20M

STATE CORPORATION COMMISSION

MAR 31 1953

CONSERVATION DIVISION
Wichita, Kansas

PLUGGING
FILE SEC 8 T 23 R 16 W
BOOK PAGE 82 LINE 22

DRILLING RECORD

15.45-00025-0600

Well No. 1 Chas. Scharz
Located NW NW NE Sec 8-23S-16W
Pawnee County, Kansas

Casing Record

249.88' of 8-5/8" OD Surface Pipe
cemented with 150 sacks.

Work Commenced 2-14-53
Drilling Commenced 2-15-53
Drilling Completed 3-3-53
Work Completed 3-4-53

No Oil String - Dry Hole

WELL LOG

| | |
|--------------------|-----------------|
| Sand & Clay | 0 to 115 |
| Clay | 115 to 165 |
| Sand | 165 to 200 |
| Shale | 200 to 250 |
| Blue Shale | 250 to 385 |
| Red Bed | 385 to 500 |
| Shale | 500 to 725 |
| Sand | 725 to 805 |
| Red Bed | 805 to 1075 |
| Anhydrite | 1075 to 1125 |
| Red Rock | 1125 to 1375 |
| Shale & Lime | 1375 to 1735 |
| Shale | 1735 to 1875 |
| Lime & Shale | 1875 to 1975 |
| Lime & Anhydrite | 1975 to 2075 |
| Lime | 2075 to 2245 |
| Lime & Shale | 2245 to 2475 |
| Lime | 2475 to 2615 |
| Lime & Shale | 2615 to 2750 |
| Shale | 2750 to 2795 |
| Lime | 2795 to 2875 |
| Lime & Shale | 2875 to 3150 |
| Shale | 3150 to 3210 |
| Lime | 3210 to 3230 |
| Lime & Shale | 3230 to 3366 |
| Lime | 3366 to 3700 |
| Shale & Lime | 3700 to 3745 |
| Lime | 3745 to 4035 |
| Chert Conglomerate | 4035 to 4055 |
| Lime | 4055 to 4146 |
| Simpson Shale | 4146 to 4175 |
| Shale & Lime | 4175 to 4215 |
| Lime | 4215 to 4221 |
| Shale & Chert | 4221 to 4286 |
| Lime Chert | 4286 to 4300 TD |

PLUGGING
 NW SEC 8 T23 R16W
 BOOK PAGE 82 LINE 22

C E R T I F I C A T I O N

State of Oklahoma, County of Tulsa, US

I, Herrick Babcock, Partner of Iron Drilling Company, certify that the above is a true and correct log of the above described well.

Signature Herrick Babcock

Subscribed to and Sworn before me this 16th day of March, 1953.

P. Michal
Notary Public