


Give All Information Completely
Make Required Affidavit
Mail or Deliver Report to:
Conservation Division
State Corporation Commission
211 No. Broadway
Wichita, Kansas

WELL PLUGGING RECORD

15-145-00175-0001

NORTH

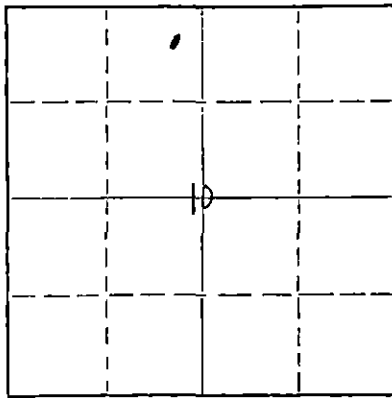

Locate well correctly on above Section Plat

Pawnee County, Sec. 10 Twp. 23S Rge. (E) 16 (W)
Location as "NE/CNWSW" or footage from lines NE NE NW
Lease Owner Halliburton Oil Producing Company
Lease Name Omar Shartz Well No. 1
Office Address 520 Cameron Bldg., Oklahoma City, Oklahoma 73106
Character of Well (completed as Oil, Gas or Dry Hole) Dry Hole
Date well completed 4-17 19 68
Application for plugging filed 4-29 19 68
Application for plugging approved 4-30 19 68
Plugging commenced 5-9 19 68
Plugging completed 5-9 19 68
Reason for abandonment of well or producing formation Dry Hole

If a producing well is abandoned, date of last production _____ 19 ____
Was permission obtained from the Conservation Division or its agents before plugging was commenced? Yes

Name of Conservation Agent who supervised plugging of this well Mr. Leo Massey
Producing formation None Depth to top --- Bottom ---- Total Depth of Well 4110 Feet
Show depth and thickness of all water, oil and gas formations.

OIL, GAS OR WATER RECORDS

CASING RECORD

FORMATION	CONTENT	FROM	TO	SIZE	PUT IN	PULLED OUT
				8 5/8"	210'	None

Describe in detail the manner in which the well was plugged, indicating where the mud fluid was placed and the method or methods used in introducing it into the hole. If cement or other plugs were used, state the character of same and depth placed, from _____ feet to 370 feet for each plug set.
Hole was filled with heavy mud to 370'. A 130 sack cement plug was placed from 370' to 45'. Top of 8 5/8" surface casing was plugged with 3 sacks of cement.

RECEIVED
STATE CORPORATION COMMISSION
MAY 21 1968
CONSERVATION DIVISION
Wichita, Kansas

(If additional description is necessary, use BACK of this sheet)

Name of Plugging Contractor _____
Address _____

STATE OF OKLAHOMA, COUNTY OF OKLAHOMA, ss.
D. D. Swearingen (employee of owner) or (owner or operator) of the above-described well, being first duly sworn on oath, says: That I have knowledge of the facts, statements, and matters herein contained and the log of the above-described well as filed and that the same are true and correct. So help me God.

(Signature) D. D. Swearingen
520 Cameron Bldg., Oklahoma City, Oklahoma 73106
(Address)

SUBSCRIBED AND SWORN TO before me this 20th day of May, 19 68

My commission expires 10-8-69

Class B. Oskey
Notary Public.

