


15-145.00175-0002

STATE OF KANSAS
STATE CORPORATION COMMISSION

Form CP-4

Give All Information Completely
Make Required Affidavit
Mail or Deliver Report to:
Conservation Division
State Corporation Commission
212 No. Market
Wichita, Kansas 67202

WELL PLUGGING RECORD

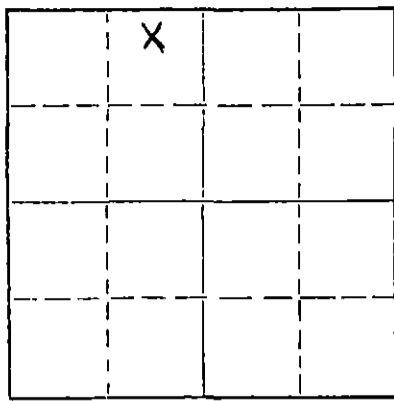

Locate well correctly on above
Section Plat

Pawnee County, Sec. 10 Twp. 23S Rge. 16W (E) (W)
Location as "NE/CNW&SW" or footage from lines C N/2 NE/4 NW/4
Lease Owner Robert F. White
Lease Name Schartz Well No. 1
Office Address 714 Union Center, Wichita, Kansas 67202
Character of Well (completed as Oil, Gas or Dry Hole) Gas
Date well completed Washed down October 16 19 69
Application for plugging filed February 16 19 72
Application for plugging approved February 19 72
Plugging commenced February 16 1972
Plugging completed February 28 1972
Reason for abandonment of well or producing formation No longer economic

If a producing well is abandoned, date of last production January 20 19 72
Was permission obtained from the Conservation Division or its agents before plugging was commenced? Yes

Name of Conservation Agent who supervised plugging of this well Leo Massey
Producing formation Mississippi Chert Depth to top 3964' Bottom 4070' Total Depth of Well 4070 Feet
Show depth and thickness of all water, oil and gas formations.

OIL, GAS OR WATER RECORDS

CASING RECORD

FORMATION	CONTENT	FROM	TO	SIZE	PUT IN	PULLED OUT
		0	210'	8-5/8"	210	none
		0	4070'	4-1/2"	4070'	2030


Describe in detail the manner in which the well was plugged, indicating where the mud fluid was placed and the method or methods used in introducing it into the hole. If cement or other plugs were used, state the character of same and depth placed, from _____ feet to _____ feet for each plug set.

February 16, 1972 Plugged off bottom. Dumped sand to 3950'. Mixed and dumped 4 sx of cement.
February 28, 1972 Plugged off top. Allied Cementing Co. mixed and pumped down 8 5/8" surface casing, 3 sx of hulls, 20 sx of gel, released plug and 100 sx of cement.

RECEIVED
STATE CORPORATION COMMISSION
MAR 24 1972
CONSERVATION DIVISION
Wichita, Kansas

(If additional description is necessary, use BACK of this sheet)
Name of Plugging Contractor RUSS CASING PULLING, INC.
Address P. O. BOX 1082 ; GREAT BEND, KANSAS 67530

STATE OF KANSAS, COUNTY OF SEDGWICK, ss.
Robert F. White (owner or operator) of the above-described well, being first duly sworn on oath, says: That I have knowledge of the facts, statements, and matters herein contained and the log of the above-described well filed and that the same are true and correct. So help me God.

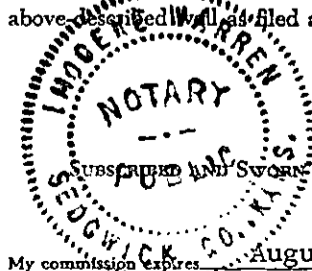

(Signature) *Ingene Warren*
714 Union Center, Wichita, Kansas 67202
(Address)

Subscribed and sworn to before me this 20th day of March, 1972
My commission expires August 6, 1975
Ingene Warren Notary Public