


STATE OF KANSAS  
STATE CORPORATION COMMISSION

WELL PLUGGING RECORD

544520667-0000

Give All Information Completely  
Make Required Affidavit  
Mail or Deliver Report to  
Conservation Division  
State Corporation Comm.  
245 North Water  
Wichita, KS 67202

Pawnee County, Sec. 12 Twp. 23S Rge. 16W  
Location as "NE/CNW $\frac{1}{4}$ SW $\frac{1}{4}$ " or footage from lines  
C NW SW

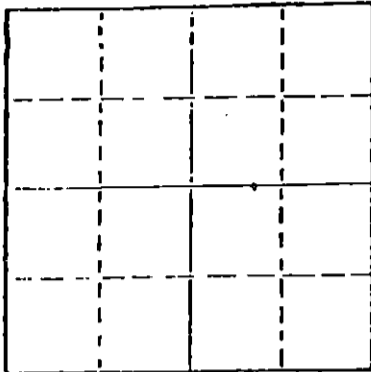

Locate well correctly on above  
Section Plot

Lease Owner Alpine Drilling Co., Inc.  
Lease Name Wurm - C Well No. 1  
Office Address 200 E. 1st, Suite 500, Wichita, KS 67202  
Character of Well (Completed as Oil, Gas or Dry Hole)  
Dry Hole

Date Well completed April 10 1980  
Application for plugging filed April 10 1980  
Application for plugging approved April 10 1980  
Plugging commenced April 10 1980  
Plugging completed April 10 1980  
Reason for abandonment of well or producing formation

If a producing well is abandoned, date of last production 19

Was permission obtained from the Conservation Division or  
its agents before plugging was commenced? yes

Name of Conservation Agent who supervised plugging of this well Marion Schmidt  
Producing formation Depth to top Bottom Total Depth of Well 4142  
Show depth and thickness of all water, oil and gas formations.

OIL, GAS OR WATER RECORDS

CASING RECORD

FORMATION	CONTENT	FROM	TO	SIZE	PUT IN	PULLED OUT

Describe in detail the manner in which the well was plugged, indicating where the mud fluid was placed and the method or methods used in introducing it into the hold. If cement or other plugs were used, state the character of same and depth placed, from feet to feet for each plug set.

Plugged hole as follows:

60 sx @ 540'; 30 sx @ 210'; 1 sx hulls & plug & 10' sx @ 40'; 5 sx in rat hole, used 50/50 pozmix, 4% gel, plug down at 8 p.m. 4-10-80

Witnessed: State Plugger - Marion Schmidt

Bill Roach

RECEIVED  
STATE CORPORATION COMMISSION

APR 15 1980

4-15-80

(If additional description is necessary, use BACK OF this sheet)

Name of Plugging Contractor HUSKY DRILLING CO., INC.

Wichita, Kansas

STATE OF KANSAS COUNTY OF SEDGWICK, ss.  
Jon T. Williams, Jr. (employee of owner) or (owner or operator)  
of the above-described well, being first duly sworn on oath, says: That I have knowledge of the facts, statements, and matters herein contained and the log of the above-described well as filed and that the same are true and correct. So help me God.

(Signature)

*Jon T. Williams, Jr.*  
200 E. First, Suite 500, Wichita, KS 67202  
(Address)

SUBSCRIBED AND SWORN TO before me this 14th day of April, 1980

*Geraldine Stewart*  
Geraldine Stewart Notary Public.

My commission expires January 12, 1981





200 E. First, Suite 500  
~~800 8th St~~  
 Wichita, Kansas 67202  
 Phone 316 - 263-7904  
 Mobile Phone 316 - 793-7859 Unit 7070

15-145-20667-0550

April 14, 1980

WELL LOG- - - - - Wurm-C No. 1  
 Located C NW SW of Sec.16-23S-16W, Pawnee Co., Kansas

OWNER: Alpine Drilling Co., Inc.  
 ROTARY CONTRACTOR: Husky Drilling Co., Inc.

COMMENCED: April 4, 1980  
 COMPLETED: April 10, 1980

Rotary Total Depth: 4142'

LOG

0 - 75 Surface soil, sand & gravel  
 75 - 265 Shale  
 265 - 455 Shale & sand  
 455 - 515 Sand  
 515 - 999 Shale - Red Bed  
 999 - 1030 Anhydrite  
 1030 - 1440 Shale & shells  
 1440 - 3657 Shale & lime  
 3657 - 3990 Lime  
 3990 - 4142 Lime & Shale

CASING RECORD

Ran 8-5/8" casing @ 262 KB,  
 28#, 8V, talled @ 255.37'; w/225  
 sx, 2% gel, 3% cc, plug down  
 @ 1:15 p.m. 4-4-80; cement did  
 circulate.

Plugged & Abandoned 4-10-80.

RECEIVED  
 STATE CORPORATION COMMISSION

APR 15 1980

CONSERVATION DIVISION  
 Wichita, Kansas