

RECEIVED
STATE CORPORATION COMMISSION

15-145-20285-0000

AUG 19 1974

8-19-74

Form CP-4


STATE OF KANSAS
STATE CORPORATION COMMISSION

CONSERVATION DIVISION
Wichita, Kansas

WELL PLUGGING RECORD

Give All Information Completely
Make Required Affidavit
Mail or Deliver Report to:

Conservation Division
State Corporation Commission
P. O. Box 17027
Wichita, Kansas 67217
NORTH

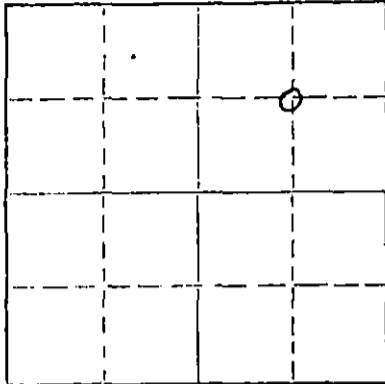

Locate well correctly on above
Section Plat

Pawnee County, Sec. 15, Twp. 23, Rge. (E) 16 (W)
Location as "NE/CNWxSWx" or footage from lines C-NE -NE
Lease Owner Alpine Drilling Co.
Lease Name Hays Taylor Well No. 1
Office Address 800 Biting Bldg. Wichita Kansas
Character of Well (completed as Oil, Gas or Dry Hole) ~~Oil~~ Gas
Date well completed 19 63
Application for plugging filed July 5 19 74
Application for plugging approved July 8 19 74
Plugging commenced July 28 19 74
Plugging completed ~~July~~ Aug. 3 19 74
Reason for abandonment of well or producing formation Dry

If a producing well is abandoned, date of last production Feb. 19 74
Was permission obtained from the Conservation Division or its agents before plugging was commenced? Yes

Name of Conservation Agent who supervised plugging of this well Leo. Massey
Producing formation K. C. Lime Depth to top 4036 Bottom 4048 Total Depth of Well 4115 Feet
Show depth and thickness of all water, oil and gas formations.

OIL, GAS OR WATER RECORDS

CASING RECORD

FORMATION	CONTENT	FROM	TO	SIZE	PUT IN	PULLED OUT
	Surface	0	265	8 5/8		
		0	4114	5 1/2		2997.59

Describe in detail the manner in which the well was plugged, indicating where the mud fluid was placed and the method or methods used in introducing it into the hole. If cement or other plugs were used, state the character of same and depth placed, from _____ feet to _____ feet for each plug set.

Filled with sand to 4000 ft. Dumped 4 sx. cement

Pumped top with 2 hulls 10 sx. jell and 100 sx. cement

(If additional description is necessary, use BACK of this sheet)


Name of Plugging Contractor Nicholas Casing Pulling
Address Box 373 Geneseo Kansas 67444

STATE OF _____, COUNTY OF _____, ss.

_____ (employee of owner) or (owner or operator) of the above-described well, being first duly sworn on oath, says: That I have knowledge of the facts, statements, and matters herein contained and the log of the above-described well as filed and that the same are true and correct. So help me God.

(Signature) George A. Nicholas

Sworn to before me this 16th day of August, 1974

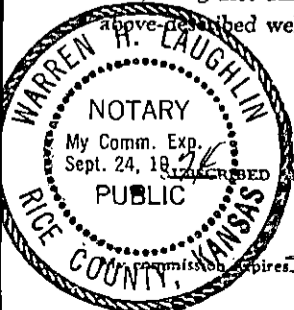

Warren H. Laughlin Notary Public.

Sept 24 1974

WOODMAN & IANNITTI DRILLING COMPANY
Rotary Drilling Contractors

1008 UNION NATIONAL BUILDING
WICHITA, KANSAS 67202

15-145-20285-0000

March 5, 1973

Company;	Alpine Drilling Co., Inc.
Farm;	#1 Hays-Traylor
Location;	Approx. C NE NE
Section;	15-23S-16W
County;	Pawnee
Comm;	February 19, 1973
Compl;	March 3, 1973
Total Depth;	4115'
Casing;	8 5/8" @ 256' w/240 sacks 5 1/2" @ 4114' w/100 sacks

Figures Indicate Bottom Of Formations:

150	Sand
256	Shale
320	Shale
500	Red Bed & Sand
550	Sand
1010	Red Bed
1033	Anhy
1100	Shale & Shells
1850	Shale & Shells
2025	Shale & Lime
2225	Lime
2425	Lime & Shale
2615	Shale & Lime
2805	Lime & Shale
2960	Lime & Shale
3140	Lime & Shale
3235	Lime
3370	Lime
3510	Lime
3620	Shale & Lime
3650	Shale & Lime
3670	Lime
3750	Lime
3810	Lime
3880	Lime
3940	Lime
3980	Lime
4030	Lime
4065	Lime
4115	Lime

RECEIVED
STATE CORPORATION COMMISSION
AUG 28 1974
CONSERVATION DIVISION
Wichita, Kansas

Woodman & Iannitti Drilling Co.

K. T. Woodman
K. T. Woodman

YOUR COPY