

WELL PLUGGING RECORD


15-145-01081-0000

Give All Information Completely
Make Required Affidavit
Mail or Deliver Report to:
Conservation Division
State Corporation Commission
212 North Market, Insurance Bldg.
Wichita, Kansas

Pawnee County, Sec. 15 Twp. 23 S Rge. (E) 16 (W)

Location as "NE/CNW%SW%" or footage from lines SW/4 SW/4 SE/4
Lease Owner Messman-Rinehart Oil Company
Lease Name Traylor (Washdown) Well No. 1
Office Address 518 Petroleum Building, Wichita, Kansas
Character of Well (completed as Oil, Gas or Dry Hole) Dry Hole
Date well completed January 2 19 62
Application for plugging filed January 2 19 62
Application for plugging approved January 2 19 62
Plugging commenced January 2 19 62
Plugging completed January 2 19 62
Reason for abandonment of well or producing formation Dry

NORTH

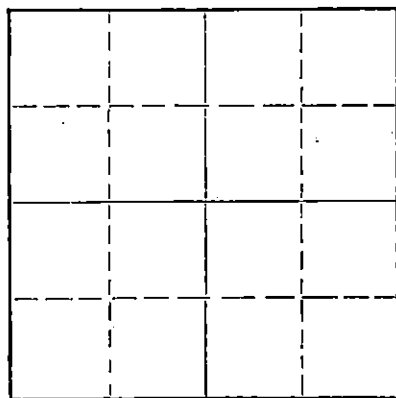

Locate well correctly on above Section Plat

If a producing well is abandoned, date of last production 19
Was permission obtained from the Conservation Division or its agents before plugging was commenced? yes

Name of Conservation Agent who supervised plugging of this well
Producing formation Depth to top Bottom Total Depth of Well 4258 Feet
Show depth and thickness of all water, oil and gas formations.

OIL, GAS OR WATER RECORDS

CASING RECORD

FORMATION	CONTENT	FROM	TO	SIZE	PUT IN	PULLED OUT
				10-3/4"	962'	none

Describe in detail the manner in which the well was plugged, indicating where the mud fluid was placed and the method or methods used in introducing it into the hole. If cement or other plugs were used, state the character of same and depth placed, from feet to feet for each plug set.

Set plug at 300 feet with 30 sx. cement and 1/2 sk. hulls. Mud to 35 feet., Set plug at 35 ft. with 10 sx. cement and 1/2 sk. hulls.

RECEIVED
STATE CORPORATION COMMISSION
FEB 8 1962
CONSERVATION DIVISION
Wichita, Kansas

2-8-62

(If additional description is necessary, use BACK of this sheet)

Name of Plugging Contractor Messman-Rinehart Oil Company
Address 518 Petroleum Building, Wichita, Kansas

STATE OF Kansas, COUNTY OF Sedgwick, ss.
J. A. Gilliland (employee of owner) of the above-described well, being first duly sworn on oath, says: That I have knowledge of the facts, statements, and matters herein contained and the log of the above-described well as filed and that the same are true and correct. So help me God.

(Signature) *J. A. Gilliland*
518 Petroleum Building, Wichita, Kansas
(Address)

SUBSCRIBED AND SWORN TO before me this 6th day of February, 19 62

Barbara J. Scott
Barbara J. Scott, Notary Public.

My commission expires December 1, 1964



WELL LOG BUREAU - KANSAS GEOLOGICAL SOCIETY
412 Union National Bk. Bldg., Wichita, Kansas


15-145-01081-0000

Company - SINCLAIR-PRAIRIE OIL COMPANY
Farm - A. W. Traylor No. 1

SEC. 15 T. 23 R. 16W
SW SW SE
330' fr SL and 330' fr WL of
SW SE

Total Depth. 4258
Comm. 11-29-47 Comp. 12-21-47
Shot or Treated.
Contractor. Harbar Drlg.
Issued. 3-26-49

County. Pawnee
KANSAS

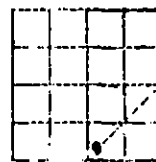

Elevation. _____

Production. Abandoned

CASING:

10 3/4" OD 962' cem w/500 sx.

Figures Indicate Bottom of Formations.

surface cly	25
sand	45
shale, shells	315
shale, sand	440
redbed, shells	495
sand	565
shale, shells	625
sand, redbed	695
redbed, shells	855
shale red, sand	995
lime	1006
anhydrite	1045
shale, shells	1700
lime, shale	2145
lime, shale brks	2170
shale	2215
shale, lime	2375
shale, shells	2485
shale, lime	2835
shale, shells	2845
shale, lime	3290
lime	3365
shale, lime	3440
lime	3505
shale, lime	3550
lime	3575
lime, shale	3640
shale	3680
lime	3750
lime brkn	3795
shale, lime	3950
lime brkn	3995
shale, lime	4032
chert	4075
shale cherty	4105
lime, conglomerate	4135
lime	4258
Total depth	

Tops:

Hoebner	3546
Douglas	3585
Brown Lime	3651
Lansing/ K.C.	3671
Simpson	4108
Arbuckle	4145

At 4175' took DST packer
at 4129-80', open 33 mins.,
10' drilling mud, At TD 4255
took Schlumberger and DST, packer
at 4202', open 30 mins, had 3025'
salt water. Will abandon