

15-145-20637-0000


STATE OF KANSAS
STATE CORPORATION COMMISSION

WELL PLUGGING RECORD

Give All Information Completely
Make Required Affidavit
Mail or Deliver Report to
Conservation Division
State Corporation Comm.
245 North Water
Wichita, KS 67202

Pawnee County. Sec. 18 Twp. 23S Rge. 16W E/W
Location as "NE/CNW 1/4 SW 1/4" or footage from lines
NW SE NE

Lease Owner D. R. Lauck Oil Company, Inc.
Lease Name Birzer-Schartz "A" Well No. 1
Office Address 221 S. Broadway, Suite 400, Wichita, Ks.
Character of Well (Completed as Oil, Gas or Dry Hole) Dry Hole

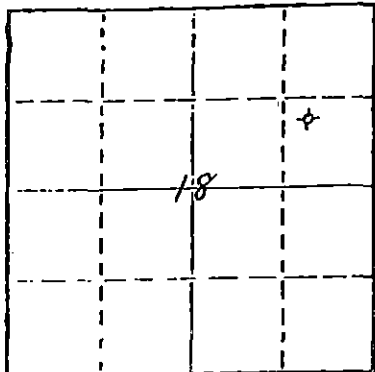

Locate well correctly on above
Section Plat

Date Well completed December 7, 1979
Application for plugging filed December 7, 1979
Application for plugging approved December 7, 1979
Plugging commenced December 7, 1979
Plugging completed December 7, 1979
Reason for abandonment of well or producing formation Dry Hole

If a producing well is abandoned, date of last production 19

Was permission obtained from the Conservation Division or its agents before plugging was commenced? Yes

Name of Conservation Agent who supervised plugging of this well Marion Schmidt
Producing formation _____ Depth to top _____ Bottom _____ Total Depth of Well 4136'
Show depth and thickness of all water, oil and gas formations.

OIL, GAS OR WATER RECORDS

CASING RECORD

FORMATION	CONTENT	FROM	TO	SIZE	PUT IN	PULLED OUT
		0'	382'	8-5/8"	375.20'	None

Describe in detail the manner in which the well was plugged, indicating where the mud fluid was placed and the method or methods used in introducing it into the hold. If cement or other plugs were used, state the character of same and depth placed, from _____ feet to _____ feet for each plug set.

Plugged with 70 sacks cement at 420',
10 sacks cement and 1/2 sack hulls
at 40'.

STATE RECEIVED
DEC 27 1979
CONSERVATION DIVISION
Wichita Kansas

(If additional description is necessary, use BACK of this sheet)

Name of Plugging Contractor Allied Cementing Co.


STATE OF KANSAS COUNTY OF SEDGWICK, ss.
John D. Knightley (employee of owner) or (owner or operator)
of the above-described well, being first duly sworn on oath, says: That I have knowledge of the facts, statements, and matters herein contained and the log of the above-described well as filed and that the same are true and correct. So help me God.

(Signature) [Signature]
221 S. Broadway, Wichita, Kansas
(Address)

Subscribed and sworn to before me this 26th day of December, 19 79

[Signature]
Notary Public.

My commission expires March 12, 1983

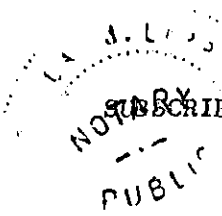

15-445-20637-0000

D. R. Lauck Oil Company, Inc. -
221 S. Broadway, Suite 400
Wichita, Kansas 67202

Birzer-Schartz "A" #1
NW SE NE Sec. 18-23S-16W
Pawnee County, Kansas

Contractor: D. R. Lauck Oil Company, Inc.
221 S. Broadway, Suite 400
Wichita, Kansas 67202

Commenced: November 29, 1979
Completed: December 7, 1979

Drillers Log

Shale	730
Shale & Shells	1880
Shale	2395
Shale & Shells	2765
Shale	3359
Lime	4136 RTD

RECEIVED
STATE CORPORATION COMMISSION
DEC 27 1979
CONSERVATION DIVISION
Wichita, Kansas