


Give All Information Completely
Make Required Affidavit
Mail or Deliver Report to:
Conservation Division
State Corporation Commission
212 No. Market
Wichita, Kansas

WELL PLUGGING RECORD

Pawnee County, Sec. 19 Twp. 23S Rge. 16 (E) 16 (W)

Location as "NE/CNW/SW" or footage from lines S¹/₂ S¹/₂ SW
Lease Owner Messman-Rinehart Oil Company
Lease Name THOMAS UNIT Well No. 1
Office Address 1432 Wichita Plaza - Wichita, Kansas
Character of Well (completed as Oil, Gas or Dry Hole) Dry Hole
Date well completed 9-30 1968
Application for plugging filed 9-30 1968
Application for plugging approved 9-30 1968
Plugging commenced 9-30 1968
Plugging completed 12:30 PM 9-30 1968
Reason for abandonment of well or producing formation No oil or gas found in commercial quantities.

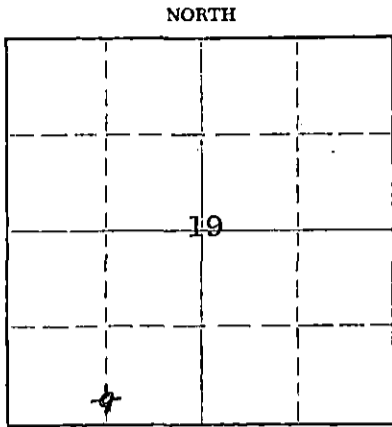

Locate well correctly on above Section Plat

If a producing well is abandoned, date of last production _____ 19____
Was permission obtained from the Conservation Division or its agents before plugging was commenced? Yes

Name of Conservation Agent who supervised plugging of this well Leo Massey, Hays, Kansas
Producing formation _____ Depth to top _____ Bottom _____ Total Depth of Well 4300 feet
Show depth and thickness of all water, oil and gas formations.

OIL, GAS OR WATER RECORDS

CASING RECORD

FORMATION	CONTENT	FROM	TO	SIZE	PUT IN	PULLED OUT
				8-5/8"	320'	-0-

Describe in detail the manner in which the well was plugged, indicating where the mud fluid was placed and the method or methods used in introducing it into the hole. If cement or other plugs were used, state the character of same and depth placed, from _____ feet to _____ feet for each plug set.

Filled hole with mud. Pumped in 200 sacks 50-50 Pozmix, 6% gel, through surface pipe.

RECEIVED
STATE CORPORATION COMMISSION
OCT 7 - 1968
CONSERVATION DIVISION
Wichita, Kansas

(If additional description is necessary, use BACK of this sheet)
Name of Plugging Contractor Rains & Williamson Oil Co., Inc.
Address 1425 Wichita Plaza - Wichita, Kansas 67202

STATE OF KANSAS, COUNTY OF SEDGWICK, ss.
Wilson Rains (employee of owner) or (owner or operator) of the above-described well, being first duly sworn on oath, says: That I have knowledge of the facts, statements, and matters herein contained and the log of the above-described well as filed and that the same are true and correct. So help me God.

(Signature) Wilson Rains Wilson Rains
1425 Wichita Plaza - Wichita, Kansas (Address)

SUBSCRIBED AND SWORN TO before me this 3 day of October 1968

My commission expires 6-30-71
Sherry Gish Notary Public.

ROTARY DRILLING LOG

15-145-20074-0000

Operator: Messman-Rinehart
Oil Company
THOMAS UNIT #1
S $\frac{1}{2}$ S $\frac{1}{2}$ SW Sec. 19-23S-16W
Pawnee County, Kansas

Contractor: Rains & Williamson
Oil Co., Inc.
Commenced: 9-21-68
Completed: 9-30-68
Casing: 8-5/8" @ 320'/200 sx.

Formations


Soil and Sand	70'
Clay	95'
Shale	1066'
Anhydrite	1086'
Shale	1900'
Lime and Shale	2845'
Shale and Lime	3250'
Lime and Shale	3835'
Lime	4270'
Lime and Chert	4300'
Rotary Total Depth (D & A)	4300'

We certify the above is true and correct, to the best of our knowledge and belief.

RAINS & WILLIAMSON OIL CO., INC.


Wilson Rains

Subscribed and sworn to before me, a Notary Public within and for the State of Kansas, County of Sedgwick, this 3rd day of October, 1968.

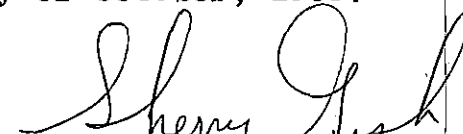
Sherry Gish Notary Public

My Commission Expires:
June 30, 1971

RECEIVED
STATE CORPORATION COMMISSION
OCT 7 - 1968
CONSERVATION DIVISION
Wichita, Kansas