


15-149-00154-0000

STATE OF KANSAS
STATE CORPORATION COMMISSION

WELL PLUGGING RECORD

Give All Information Completely
Make Required Affidavit
Mail or Deliver Report to:
Conservation Division
State Corporation Commission
800 Bittling Building
Wichita, Kansas

Pawnee County. Sec. 19 Twp. 23S Rge. (E) 16 (W)
Location as "NE/CNW&SW&" or footage from lines NE NE SE
Lease Owner Graham-Messman-Rinehart Oil Company
Lease Name Thomas "A" Well No. 1
Office Address 1005 East Second, Wichita, Kansas
Character of Well (completed as Oil, Gas or Dry Hole) Dry Hole
Date well completed June 2, 1955 19
Application for plugging filed June 3, 1955 19
Application for plugging approved June 6, 1955 19
Plugging commenced June 29, 1955 19
Plugging completed July 1, 1955 19
Reason for abandonment of well or producing formation Dry Hole

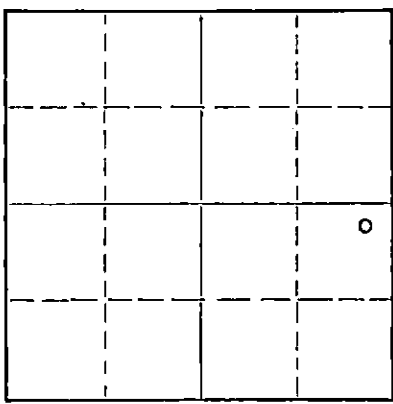

Locate well correctly on above
Section Plat

If a producing well is abandoned, date of last production 19
Was permission obtained from the Conservation Division or its agents before plugging was commenced? Yes

Name of Conservation Agent who supervised plugging of this well Warren Horner, Great Bend, Kansas
Producing formation Depth to top Bottom Total Depth of Well 4335 * Feet
Show depth and thickness of all water, oil and gas formations. *O.T.D. 4343 - Washed down old hole.

OIL, GAS OR WATER RECORDS

CASING RECORD

FORMATION	CONTENT	FROM	TO	SIZE	PUT IN	PULLED OUT
				8 5/8	702	None
				5 1/2	1289	2108

Describe in detail the manner in which the well was plugged, indicating where the mud fluid was placed and the method or methods used in introducing it into the hole. If cement or other plugs were used, state the character of same and depth placed, from feet to feet for each plug set.

Plugged back with crushed rock from 3855' to 3840'. Dumped 5 sacks cement at 3840' with dump bailer. Top of cement, 3815'. Filled hole with mud to 300', set rock bridge, dumped 20 sacks cement, top of cement, 240'. Filled with mud to 35', set rock bridge and dumped 10 sacks cement for cap.

(If additional description is necessary, use BACK of this sheet)

Name of Plugging Contractor J&M Casing Pulling Company (License No. 11)
Address Great Bend, Kansas

STATE OF Kansas, COUNTY OF Sedgwick, ss.
J. A. Gilliland (employee of owner) or (owner or agent) of the above-described well, being first duly sworn on oath, says: That I have knowledge of the facts, statements, and matters herein contained and the log of the above-described well as filed and that the same are true and correct. So help me God.

(Signature) [Signature]
1005 East Second, Wichita, Kansas (Address)

SUBSCRIBED AND SWORN TO before me this 13th day of July, 1955

1-31-57

My commission expires November 5, 1958

RECEIVED
STATE CORPORATION COMMISSION
JUL 14 1955
CONSERVATION DIVISION
Wichita, Kansas
Notary Public.

PLUGGING
PAGE 19 T 23 R 164
LOOK PAGE 124 LINE 23